
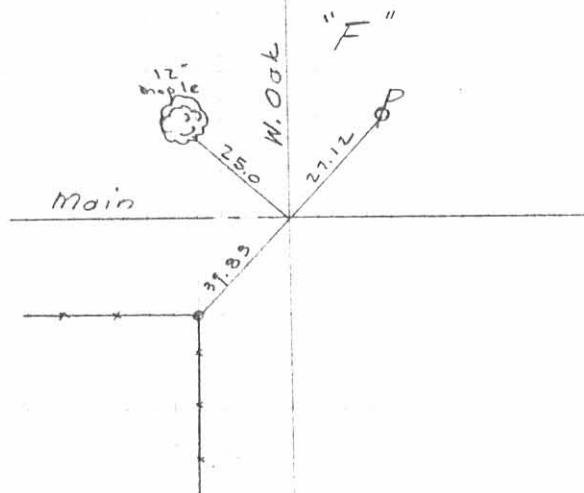
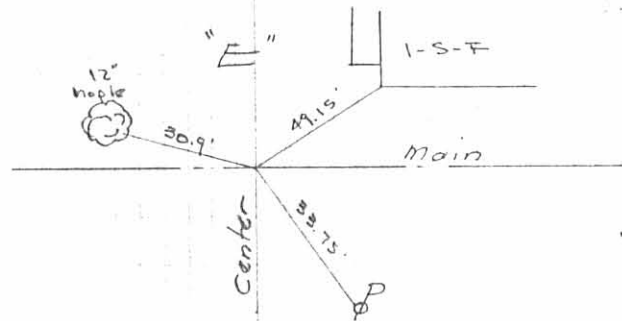
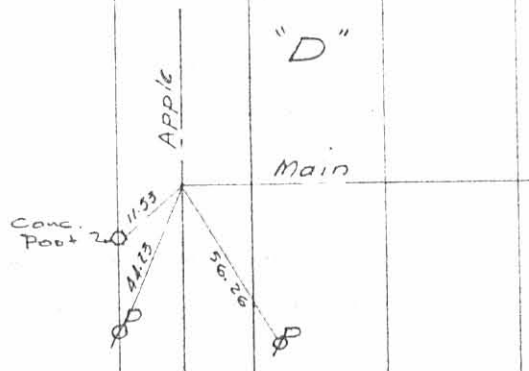
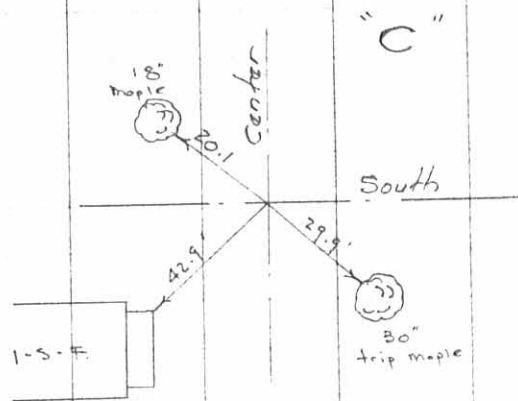


LOGANSVILLE STREETS

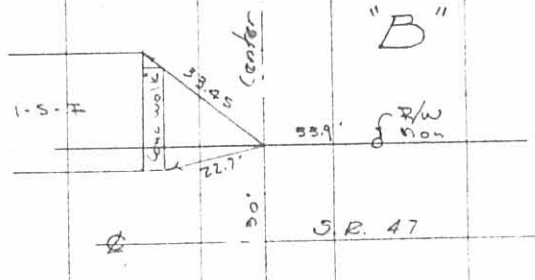

INDEXED ON MAP
4339 1P-2

LOGANSVILLE STREETS
PLEASANT TOWNSHIP

- A = Cor. post
 B = 1" # Bar set @ E Center St. & N. line 47
 C = 1" # Bar set @ E South & E Center
 D = 1" # Bar set @ E Apple & E Main
 E = 1" # Bar set @ E Main & E Center
 F = 1" # Bar set @ E Main & E White Oak

Lots 33 & 34 Surveyed for
Township Trustees. Oct. 1962

1" # Bars set on lot corners as
indicated "o".

LOGANSVILLE

PLAT BK B, Vol. 2, Pg 29

LOTS - 66 x 132

ALLEYS - 16 1/2'


R/W stakes set on Main St.
from W. Oak east to alley

April 2, 1965 D.L. Dodson

Dodson
Touis
Circ

Oct. 1962

69

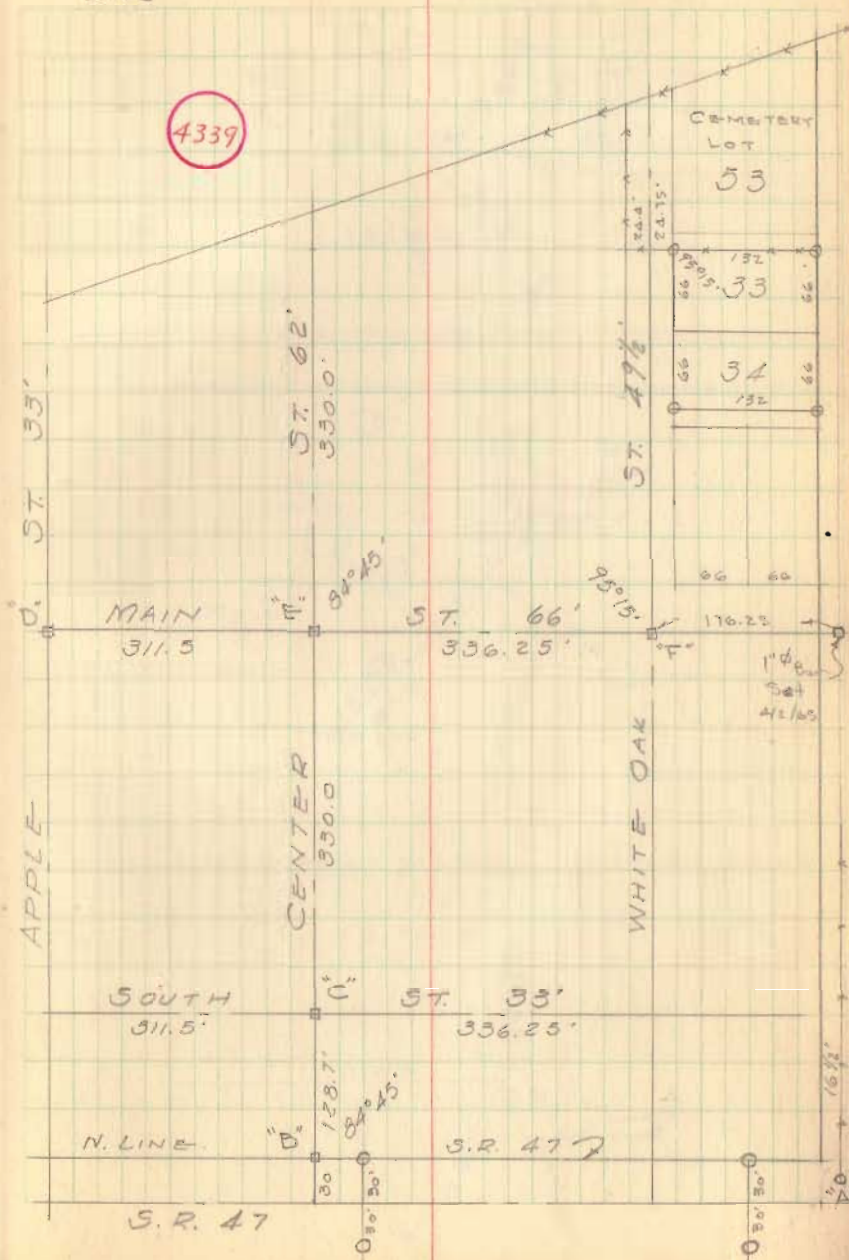

LOGANSVILLE STREETS

