


Run at 76 poles, 166 poles to a stake, corner to Withers said survey
thence ≈ 38 m with the north line of said survey 60 poles to the
beginning, containing 139 1/2 acres

James Dickerson }
Burya Vickers } b.l.

James W. Morrison
Surveyor of Logan County O.

1st mo. Jan 24th 1824 Survey No 26 (8169)

Surveyed 25 acres of land for Isaac Zane; beginning at a stake on
the Columbus road, comes to 25 acres deeded to the said Zane by Simon
Kenton jnr. thence with road N 1/2 E 37 1/2 poles to a sugar tree and creek
on the west side of said road; thence S 81 W 10 1/2 poles to a small white
walnut and hickory in the west line of Milliamt Cohrens survey 2267
thence with said line ≈ 10 W 37 1/2 poles to a small
elm & sugar tree; thence ≈ 50 E 10 1/2 poles to the
beginning containing 25 acres part of Cohrens
said survey, on the waters of Mad River

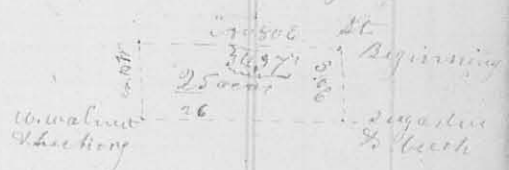

Joseph Collins }
Saml. Hatfield } b.l.

James W. Morrison
Surveyor of Logan County

2nd mo. Feb 15th 1824 Survey No 27 (8176)

Surveyed and divided the north half of section 31 in Town 3
Range 14th Co. W. Va. for Benjn Scholes & Thomas Macarson
beginning at the N.W. corner of said section a bottom oak 18 inches
in diam. 624 1/2 links dist, original corner; thence east between
Sec 31 & 32, 320 poles to the original corner
of Sec 31, 32, 25, & 26, a post in a prairie
a white 30 inches in diam, bears S 16 E 77 links
dist thence South between Sec 31 & 25, 163



poles to a stake in a prairie; thence west 320 poles to a white oak 26
inches in diam. 624 1/2 10 links dist, in the west line of the section
thence with said line 163 poles to the beginning
thence a stake in the prairie at the center of the last line east &
west line run north 163 poles to a stone in the north line of said
Sec dividing the north half of said section into two parts of 163 acres
each.

John Scholes }
William Blair } b.l.

James W. Morrison
S. L. b.