


FB 699

Survey of Miami St.  
Quincy, Ohio

Miami St. - 49 1/2' wide


See F.B. # 492 pg 59

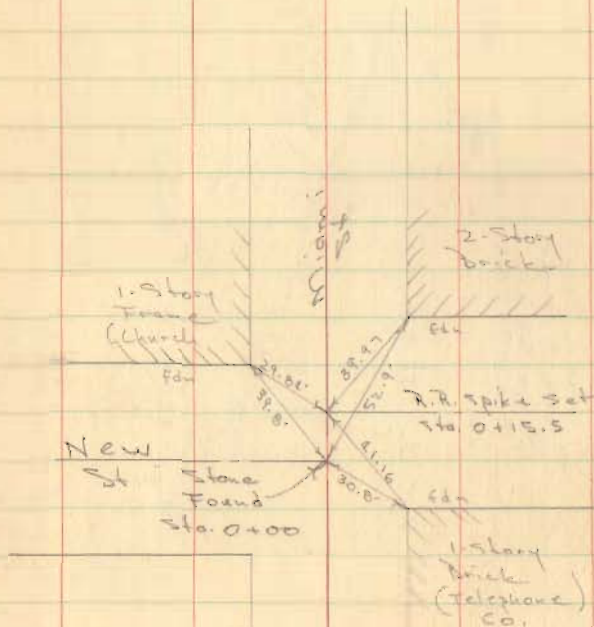

D. Deaton  
T. Richardson  
C. Nichols

Sept. 24, 1954  
65°

25

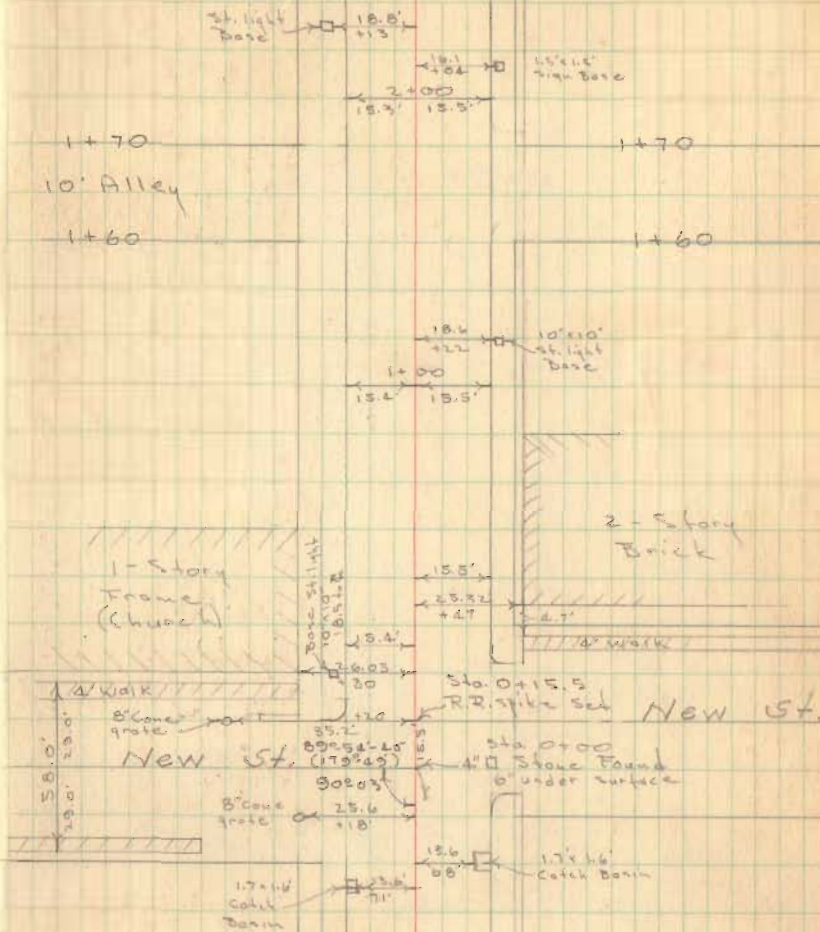

INDEXED ON MAP

2127

150.3' Track

163.4' Track

188.3' Spur

224' B/W Line



FB 699

Miami St.  
Quincy, O.

37

