


Coyer Survey
Lot 96 - QUINCY

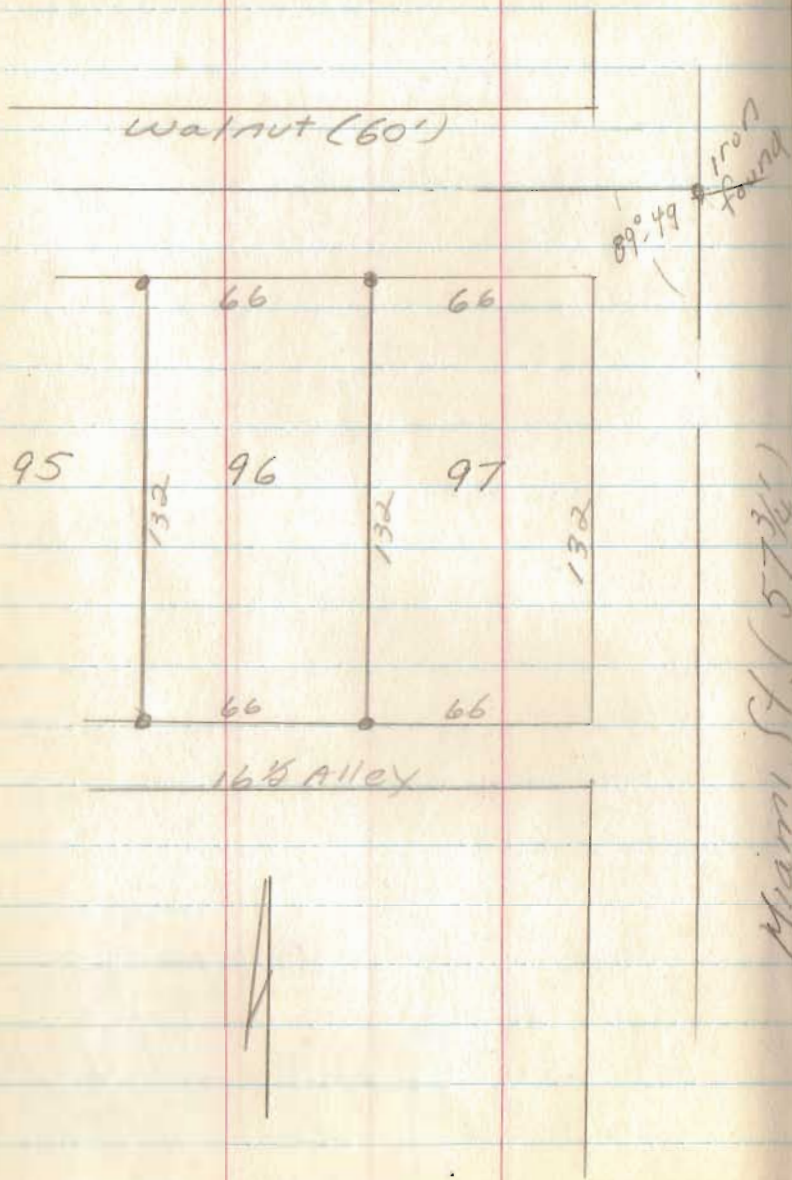

8-2-71

3

see BK 1, pg 33

filed


6439

INDEXED ON MAP

Quincy

June, 52

Shirk
Dudson 51

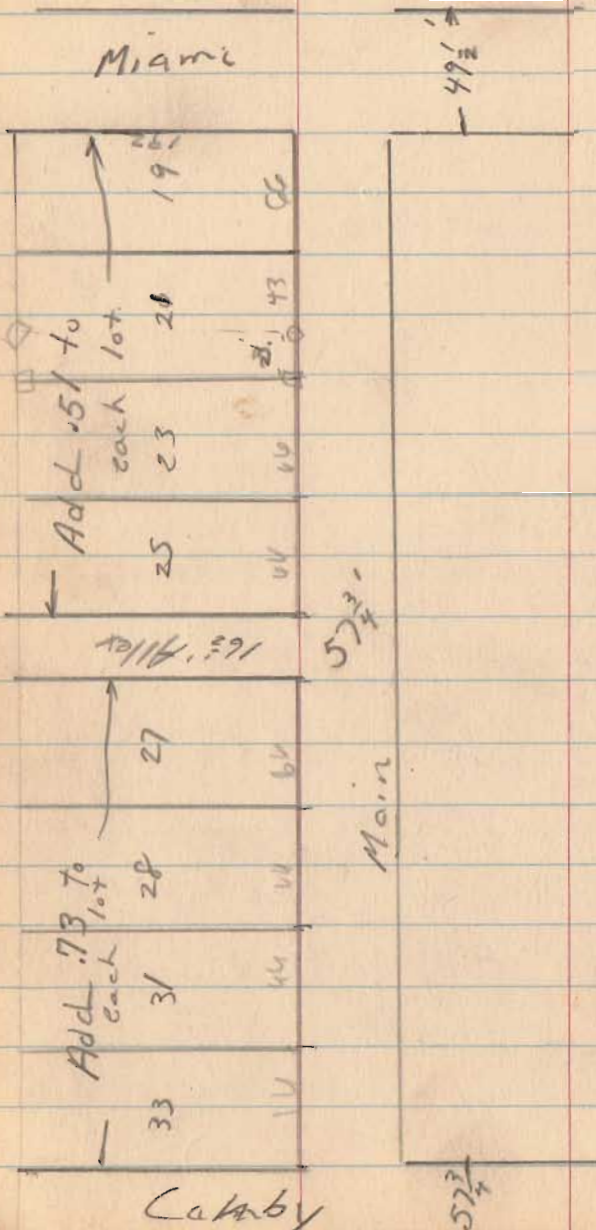

6349

INDEXED ON MAP