


REC ID 6-10-97 *SMY*



LEGEND

- 5/8 IRON ROD SET
- ⊗ RAILROAD SPIKE FOUND
- 3/4 IRON PIPE FOUND
- 1" IRON PIPE FOUND
- CONCRETE RIGHT-OF-WAY MONUMENT FOUND

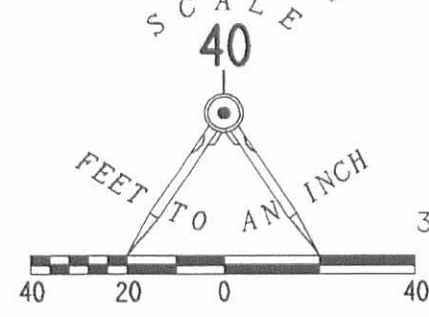

RETRACEMENT SURVEY OF THE PAUL M. TEAGUE  
 NORTH HALF OF LOTS 223, 224 AND 225  
 OFFICIAL RECORD 296, PAGE 495  
 SECTION 23, TOWN 3, RANGE 13  
 VILLIAGE OF QUINCY  
 MIAMI TOWNSHIP  
 LOGAN COUNTY, OHIO

2 WORKING DAYS  
**BEFORE YOU DIG**  
 CALL TOLL FREE **800-362-2764**  
 OHIO UTILITIES PROTECTION SERVICE.

SECTION 29, TOWN 3 RANGE 13  
 SECTION 23, TOWN 3 RANGE 13

INDEXED ON MAP  
 9134 1P



ORIGINAL STAMP IN GREEN

SURVEYED BY:  
*[Signature]*  
 JEFFREY I. LEE  
 PROFESSIONAL SURVEYOR 6359  
 JUNE 3, 1997

COPYRIGHT 1997 BY:  
**LEE SURVEYING & MAPPING CO., INC.**  
 117 North Madriver Street  
 BELLEFONTAINE, OHIO 43311  
 (937) 593-7335