


7794
4125
1190

Survey for John O'Connor
in survey 0968 Richland, Tex.
Nov 14 1938

A = point shown to me by John O'Connor
and near apple stump.
B = stone found
C = stone found

100
100
77

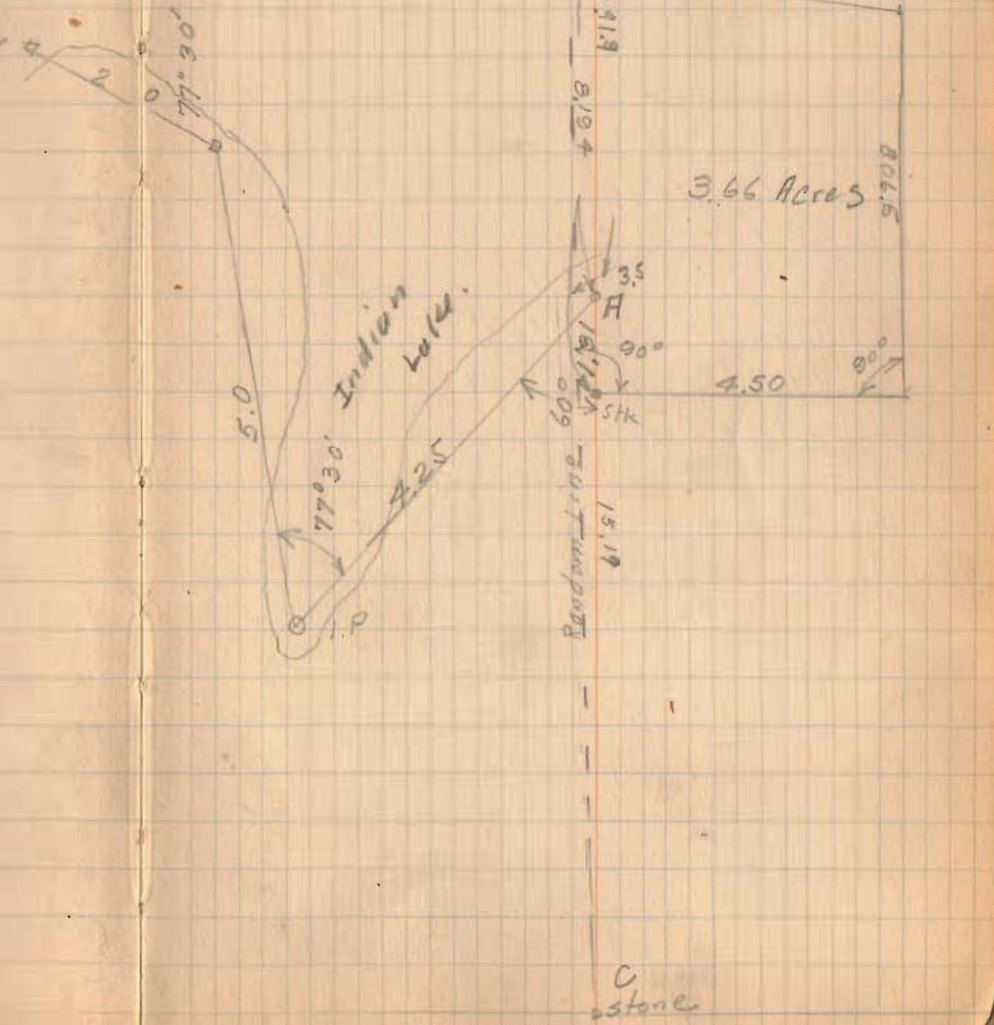

760
INDEXED ON MAP