

LOT 55
LONG ISLAND


- A 3/4" Pipe found
- B 3/4" Bar found, 49.7' from A,
reset at 50.0'
- C 3/4" Bar found, 99.9' from
A, reset at 100.0'
- D 3/4" Pipe found 300.0' from A
- E 5/8" Bar set - 4' from water
- F 5/8" Bar set at Cor. of Boat
house, 6 1/2' from water

INDEXED ON MAP
2256

Dodson
Geeslin

9-24-60

72

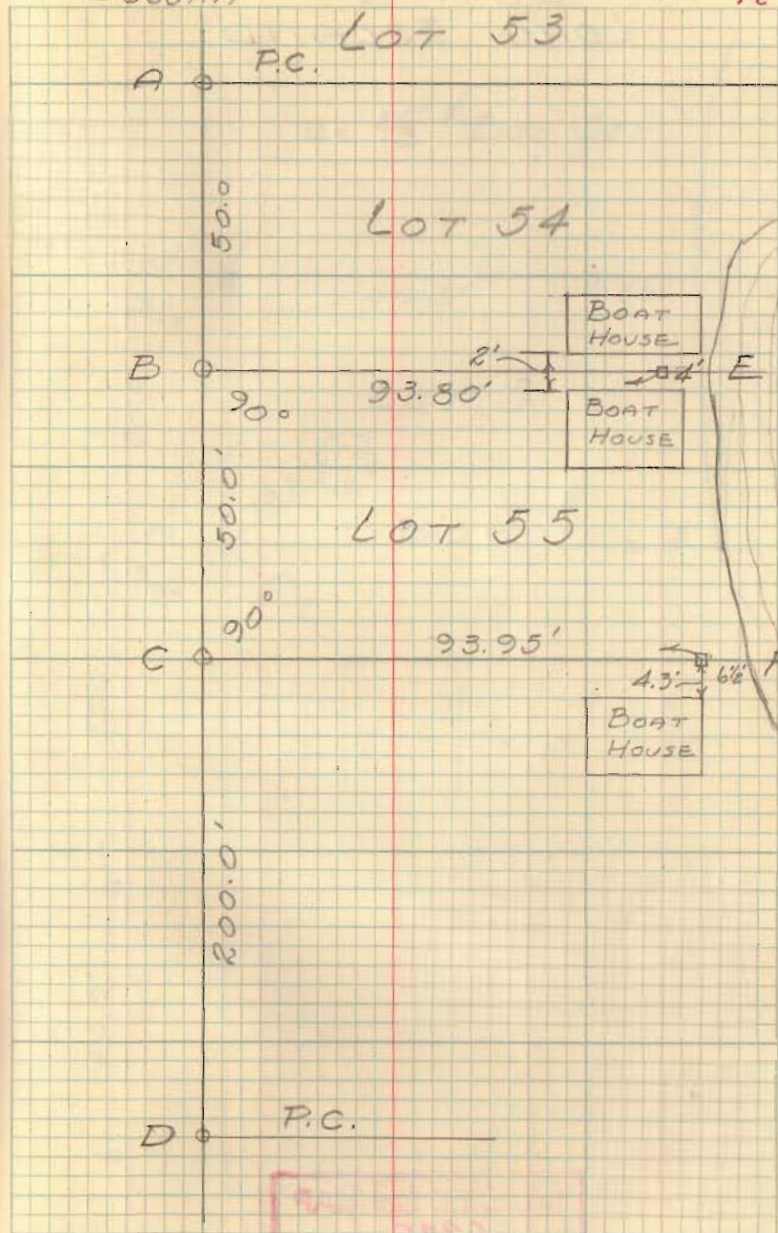

Lot 55
Long Island

- A = $\frac{3}{4}$ " pipe found
B = $\frac{3}{4}$ " Bar Found 49.7 from A
set at 50.0
C = $\frac{3}{4}$ " Bar Found 99.9 from
A, set at 100.0
D = $\frac{3}{4}$ " pipe found 300.0
from A.
E = $\frac{5}{8}$ " Bar set between
boat houses
F = $\frac{5}{8}$ " Bar set @ cor. of
Boat house


Bk 3/72

INDEXED ON MAP
2256

Dodson
Geoslin

9/24/60

5

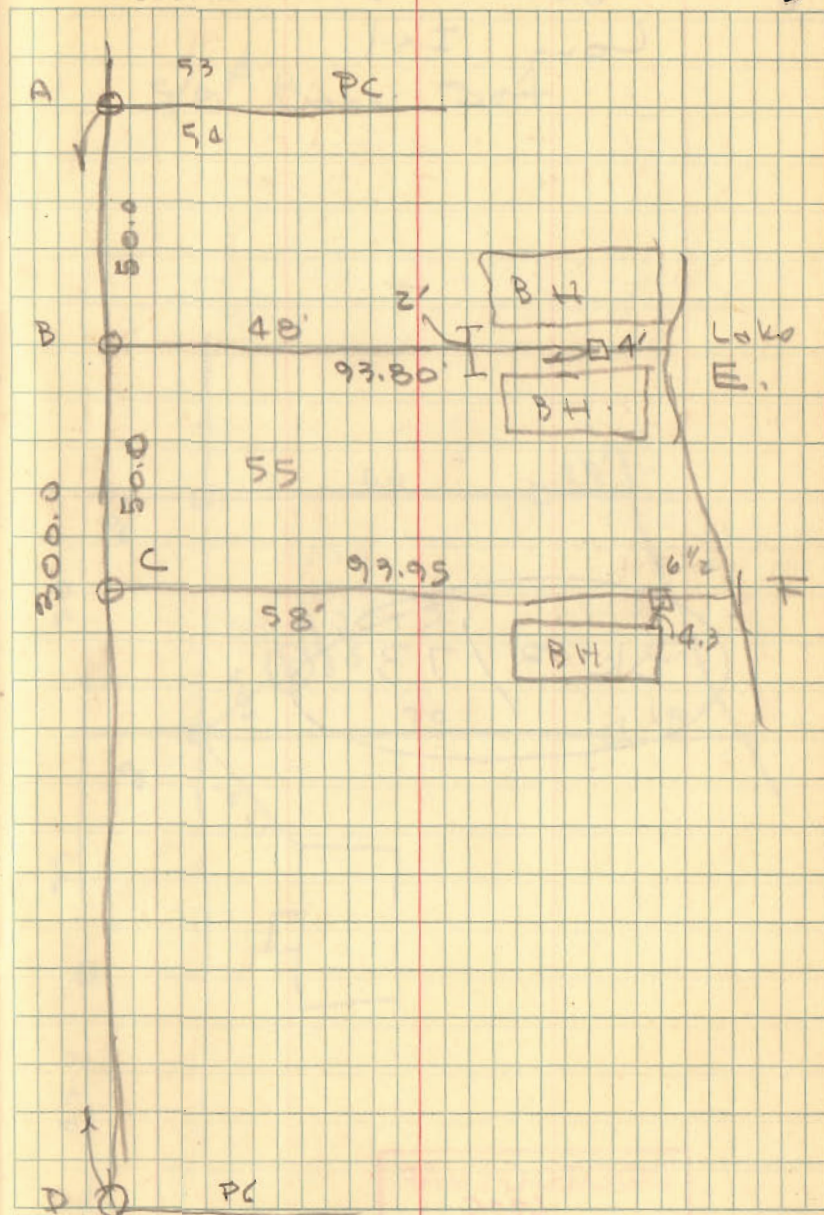


Pipe
Found

Survey of Lot 53
 Fernwood (Long Island)
 Richland Twp Logan County,
 YMS 13393
 for
 Hilliker & Wrey

Plat Book B Page 76
 Logan County Records

8-11-45
 C. A. Myskeep
 W. Wrey
 2 - Wrey helpers.

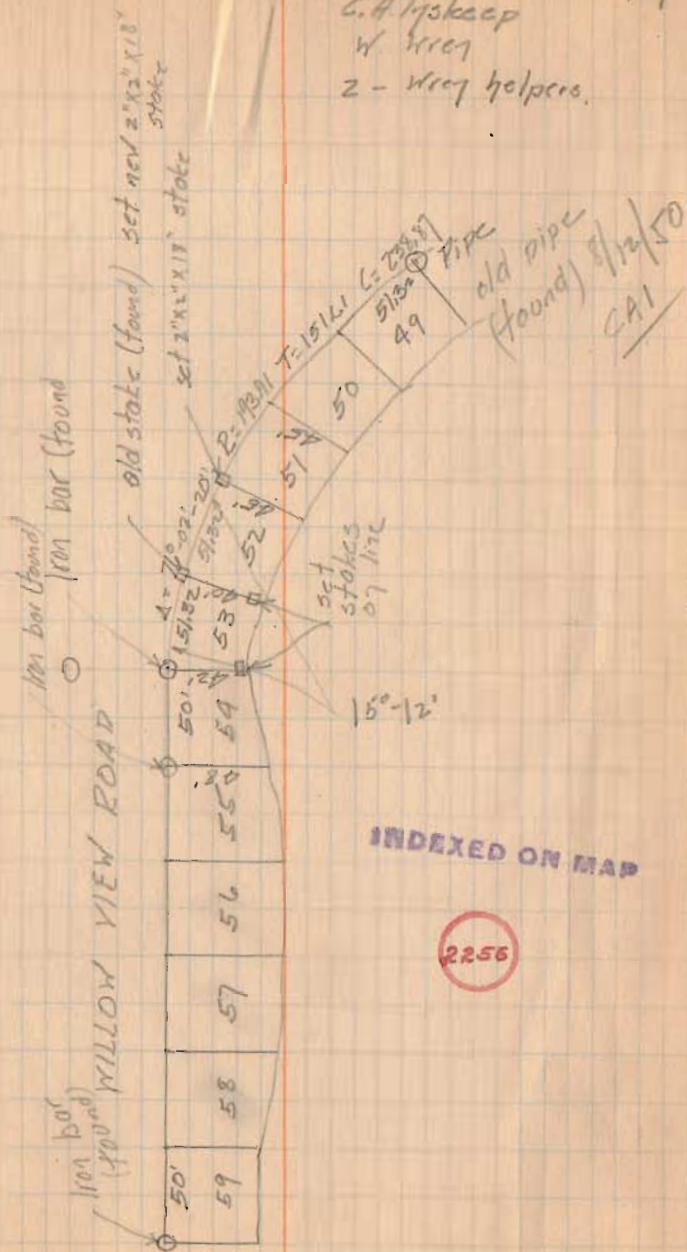

INDEXED ON MAP

2256