

116

2/19/2001 3/20/01
 F. Howell
 R. Rogers

Staking Lots 36-37-38-39

T O Corners Sub 17 12276

Richland Twp Logan Co Ohio

Front Line Lots 36, 37, 38, 39

2-53-35 Cor to Lots 36, 37

5-49-09 37.38

2-48-17 35.29

14-02-92 39-

Front Line Lots 40-41-42

5-07-09 70' Cor Lots 40-41


11-17-25 70' " " 41-42

11-20-43 11.95 on Lot 42

$$\begin{array}{r} 2925 \\ \times 14.31 \\ \hline 116925 \\ 105000 \\ \hline 419250 \end{array}$$

$$\begin{array}{r} 15299 \\ \times 2.31 \\ \hline 35340 \end{array}$$

$$\begin{array}{r} 5-51-01 \\ 2-50-07 \\ 2-27-07 \\ 2-26-26 \\ \hline 11.95 \end{array}$$

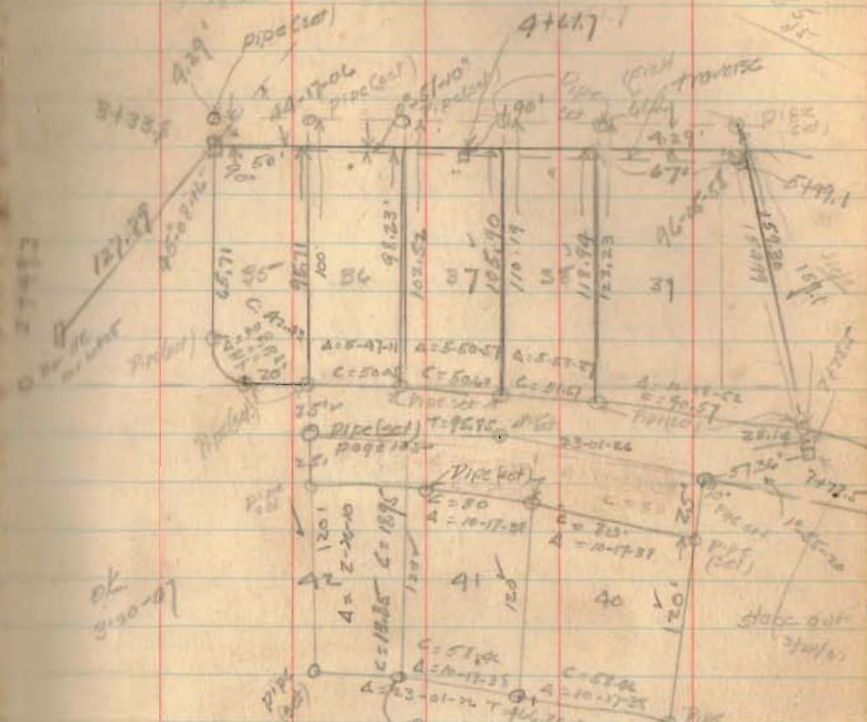

L. Date.	Front Lot Line	Rear Lot Line
A = 23-01-76	23-01-22	23-01-22
R = 02832	445.82	325.72
T = 96.891	90.70	66.36
C = 187.92	171.32	130.30
Arc = 169.20	179.15	130.92

2320

INDEXED ON MAP