


O'Connor's ANotment

Core
Wilgus
Mitchell
6/1/45

Park

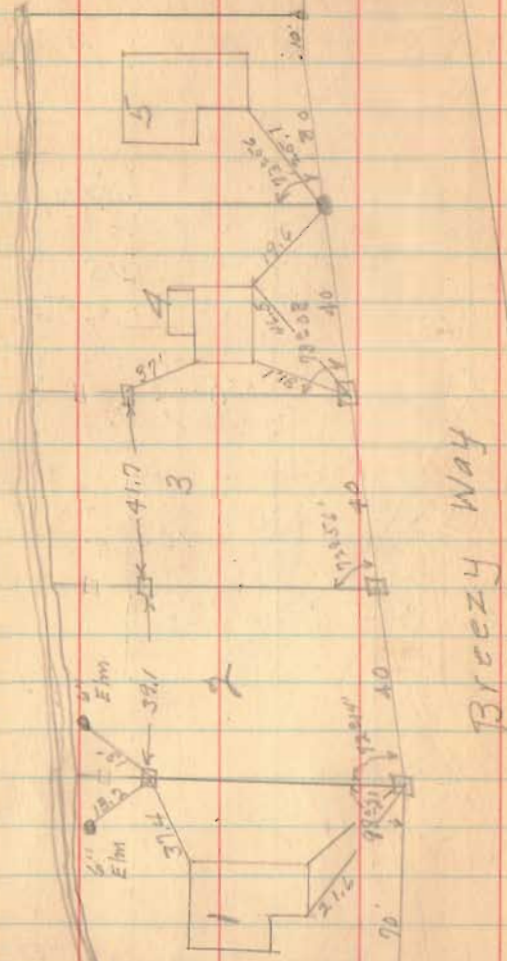

Breezy Way

3727

INDEXED ON MAP