

MILROY TO HOCHSTETLER SURVEY

Received 9-16-87 OK 9-18-87 C.R

The following described real estate situated in the Township of Richland, County of Logan, State of Ohio and being a part of Virginia Military Survey No. 9950 and being taken from Tract VI Parcel II of 85.02 Acres in the name of Ruth Milroy et al and being more particularly described as follows:

Beginning at an 1 inch iron pipe badly bent (Note: I removed said pipe and replaced it with a 5/8" x 30" Rebar set), said iron pipe was Station No. 16 + 44.0 of the survey of C. H. No. 105 as recorded in Logan County Engineer's Field Book No. 511 Page 47 (9-12-1929); said iron pipe being the southeast corner to Tract VI Parcel II of 85.02 Acres as recorded;

Thence with the south line of said tract as witnessed by an old fence line, S. 81° 45' W. 428.28 feet to a 5/8" x 30" Rebar set next to a wooden corner post;

Thence N. 10° 45' W. 395.27 feet to a 5/8" x 30" Rebar set;

Thence N. 79° 15' E. 427.87 feet to a R. R. Spike set in the centerline of C. H. No. 105 as designated in F. B. No. 511, passing the center of a creek at 207.8 feet, plus or minus and a 5/8" x 30" Rebar set at 402.87 feet;

Thence with the centerline of C. H. No. 105 as designated in F. B. No. 511, S. 10° 45' E. ^(BASIS OF BEARING) 413.95 feet to the place of beginning, passing the north end of said bridge located on this road at 10.00 feet, containing 173,117.685 square feet or 3.974 Acres, more or less.

Of the above described tract, there is 10,300.00 square feet or 0.236 Acres in the right of way of C. H. No. 105.

I hereby certify that this is a true and accurate description of a field survey made by me on September 10, 1987.

Daniel E. Gilbert

Daniel E. Gilbert, P.S.
Reg. Sur. No. 5402
400 N. Park Street
Bellefontaine, Ohio
43311




INDEXED ON MAP
7679

1D

RUTH MILROY ETAL
O.R. VOL. 5 P. 203
(7-23-1985)

PER. PAR. No. 36-035-00-00-016
85.02 ACRES

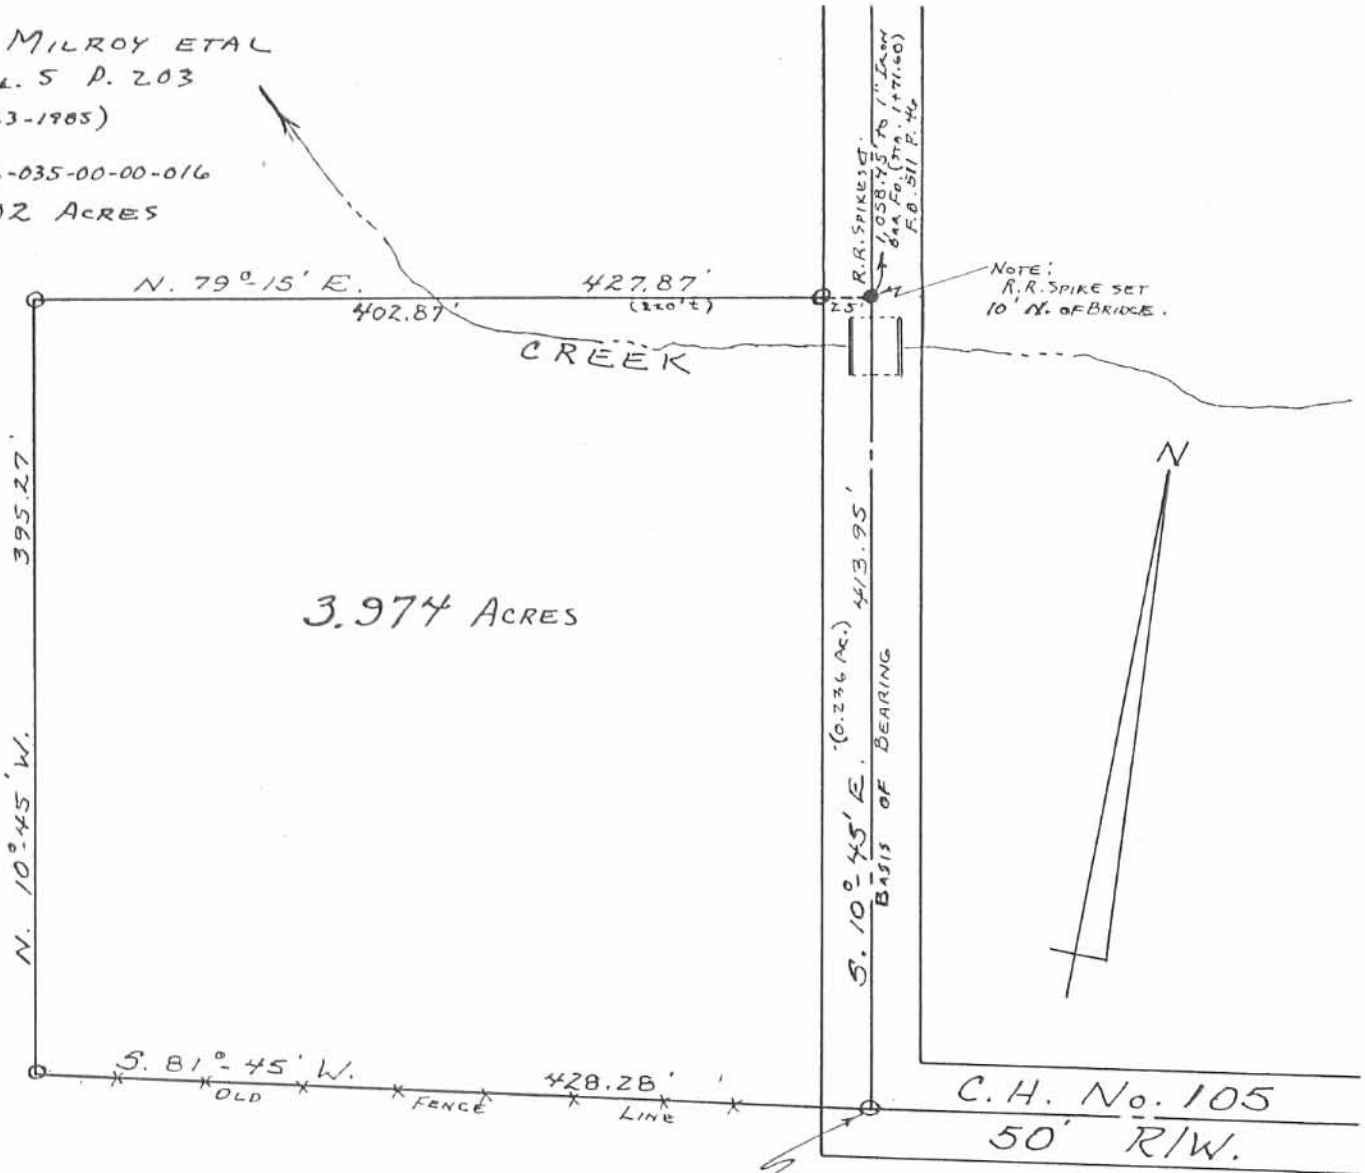

3.974 ACRES

RUTH MILROY ETAL
O.R. VOL. 5 P. 203
(7-23-1985)

PER. PAR. No. 36-035-00-00-014.001
90.56 ACRES

NOTE:
FOUND 1" IRON PIPE
BADLY BENT. REMOVED IT
PLACED 5/8" X 30" REBAR

SEE STA. 16+44
F.B. 511 P. 47

0 - 5/8" X 30" REBARS SET.

INDEXED ON MAP
7679 1P

Daniel E. Gilbert
DANIEL E. GILBERT, P.S.
REG. SUR. No. 5402
400 N. PARK ST.
BELLEFONTAINE, OHIO
43311



MILROY TO HOCHSTETLER
SURVEY
V.M.S. No. 9950
RICHLAND TOWNSHIP
LOGAN COUNTY, OHIO
SEPTEMBER 10, 1987

SCALE: 1" = 100'