


N.

8678

H. C. Moore

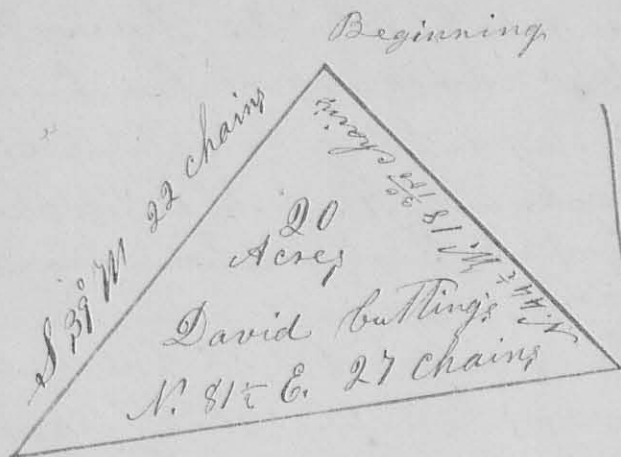

Scale

85 chains, or
3/4 poles to
an Inch

Surveyor's Office Bellefontaine
Ohio July 30th 1858

The above plat is a representation of 20 acres of land as surveyed by me, H. C. Moore, County Surveyor - of Logan County Ohio, on the 18th day of June A. D. 1858, for, & by the request of Robert Johnson, for the purpose of laying off twenty acres of land sold by the said Robert Johnson to David Cutting, and which was conveyed by Warranty Deed to the said Cutting by the said Johnson & his wife on the 15th day of June A. D. 1858. Said 20 acres of land being a part of 50 3/4 acres of Robert Meanies entry of Virginia Military Survey No. 9952 in Richland & Rushcreek Townships, deeded to said Robert Johnson by Cornelius Jamison and wife March 14th A. D. 1858. I surveyed & laid off said 20 acres in the following manner;

To-wit: Beginning at a stone & some brick-bats in the County Road leading from North Wood to the Big Spring, from which a stone at the corner between the lands of Alvin Clark

and James Trumbell bears S. 39° W. 19 links distant; Thence run S. 39° W. 22 chains (with the said Co. Road nearly all this distance) to a Stone; Thence N. 81½ E. 27 chains to a stone from which a Beech 10 Ln. Dim. bears North 31° E. 9 links; & a Beech 14 Ln. Dim. N. 59½ W. 37 links; Thence N. 44½ W. 18. ³⁰/₁₀₀ chains to the place of beginning containing twenty acres.

Chain carries


I hereby certify the foregoing plat & report to be correct: H. C. Moore, County Surveyor of Logan Co. Ohio

Survey No: 791 -

8629

Mag. Mer.

Scale
20 Chains
to an Inch

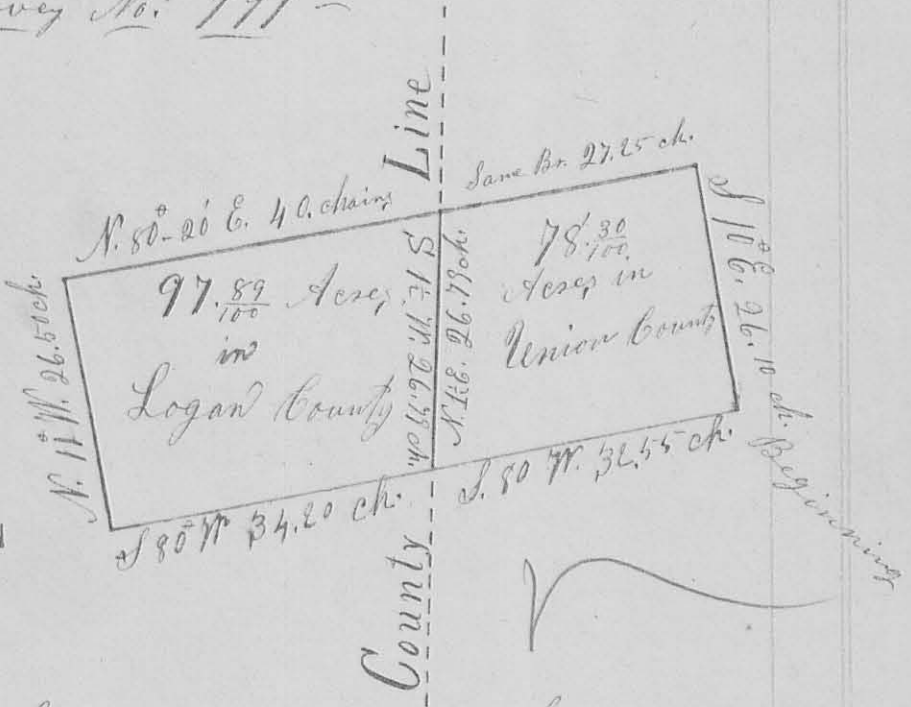

Surveyor's Office Bellefontaine Ohio
July 30th A.D. 1858

The above plat is a representation of a part of Virginia Military Survey No. 9915, as Surveyed by me, H. C. Moore County Surveyor of Logan County Ohio on the 27 day of July A.D. 1858, at the request of James S. Robinson (agent) for the purpose of establishing the line & corner there to, & ascertaining the area