

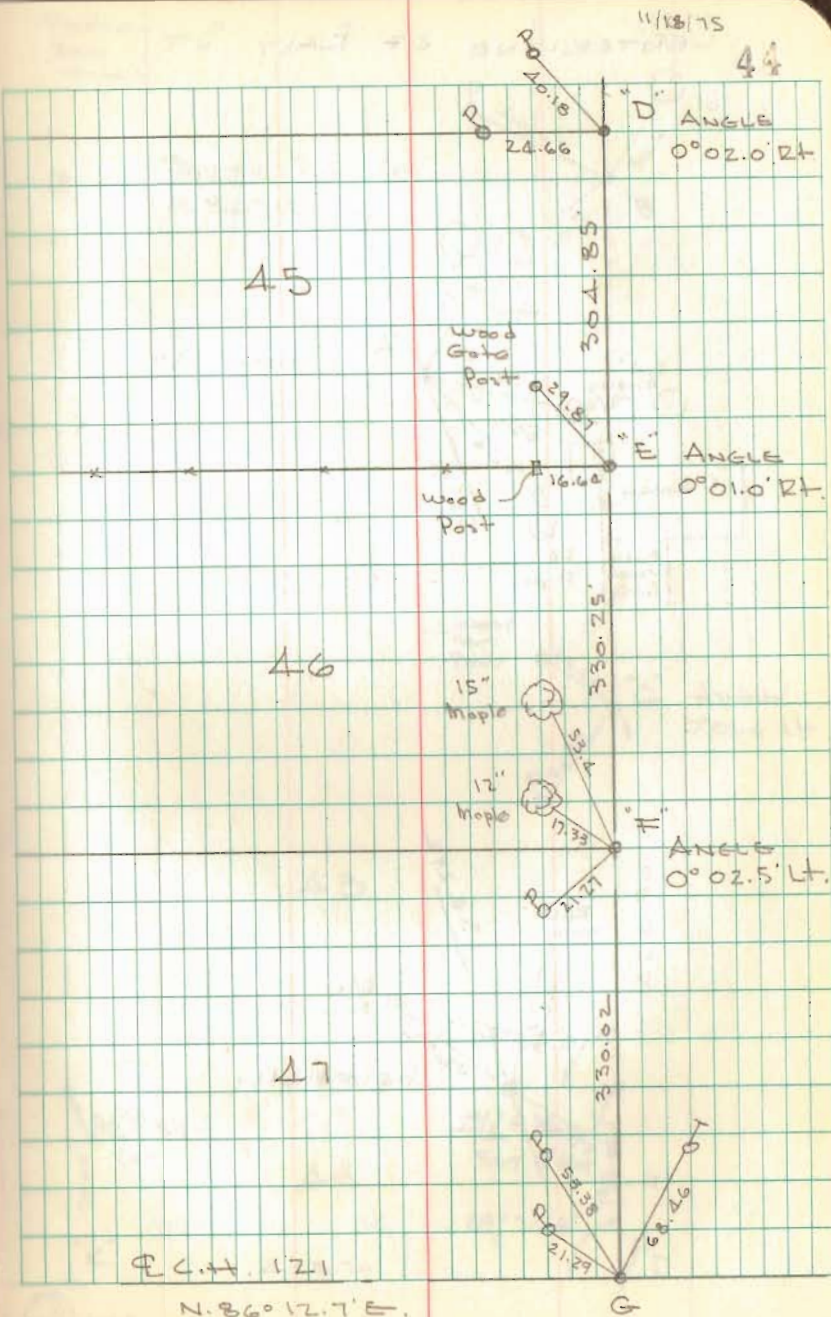


LOT 44 CONTO
CENTERLINE OF EAST STREET


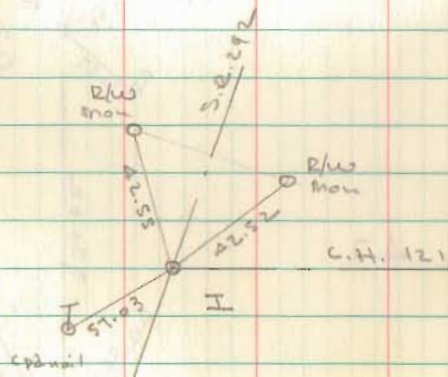


CENTERLINE OF EAST ST

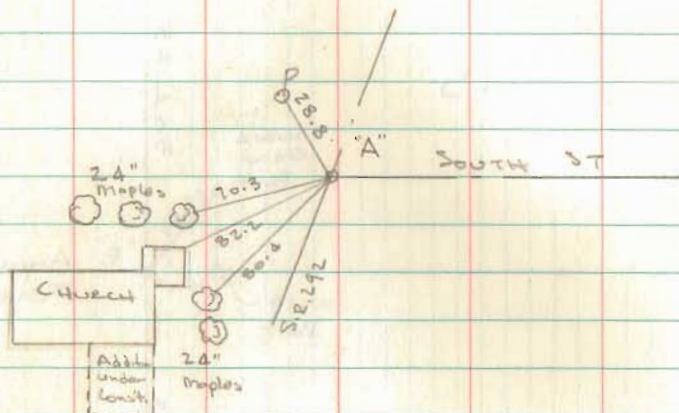


Dodson
Bow
Nichols

11/18/75
75° 45

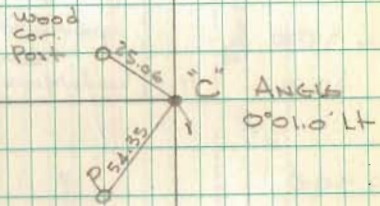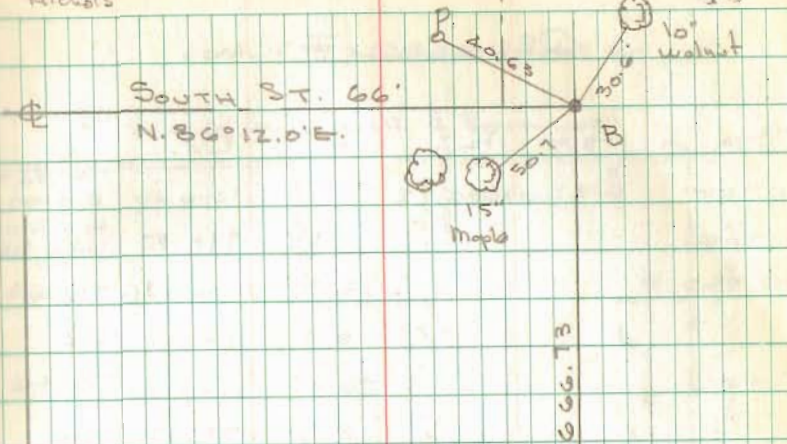

43

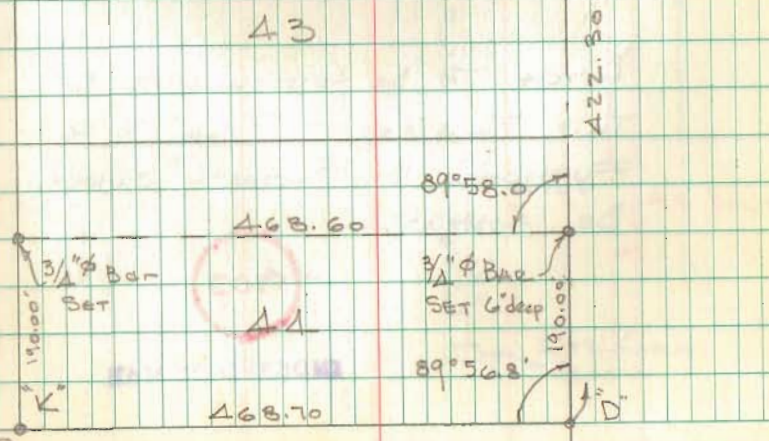

28" OPK