

Road 49
Richland Twp


Stakes Wood 20' from for a 40' road.

No Road Record.

(1371)
INDEXED ON MAP

April - 29 - 1932

25

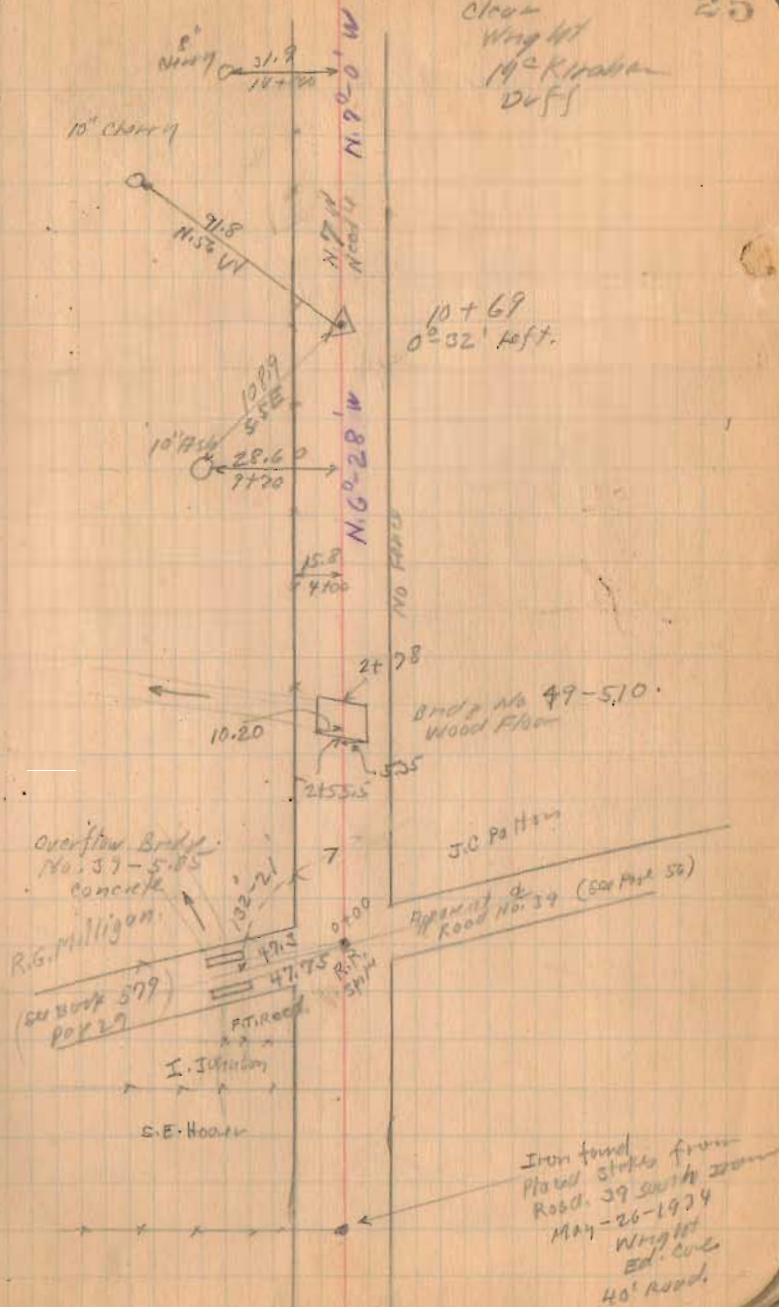


Road 49

1371

INDEXED ON MAP

4/28/32

27

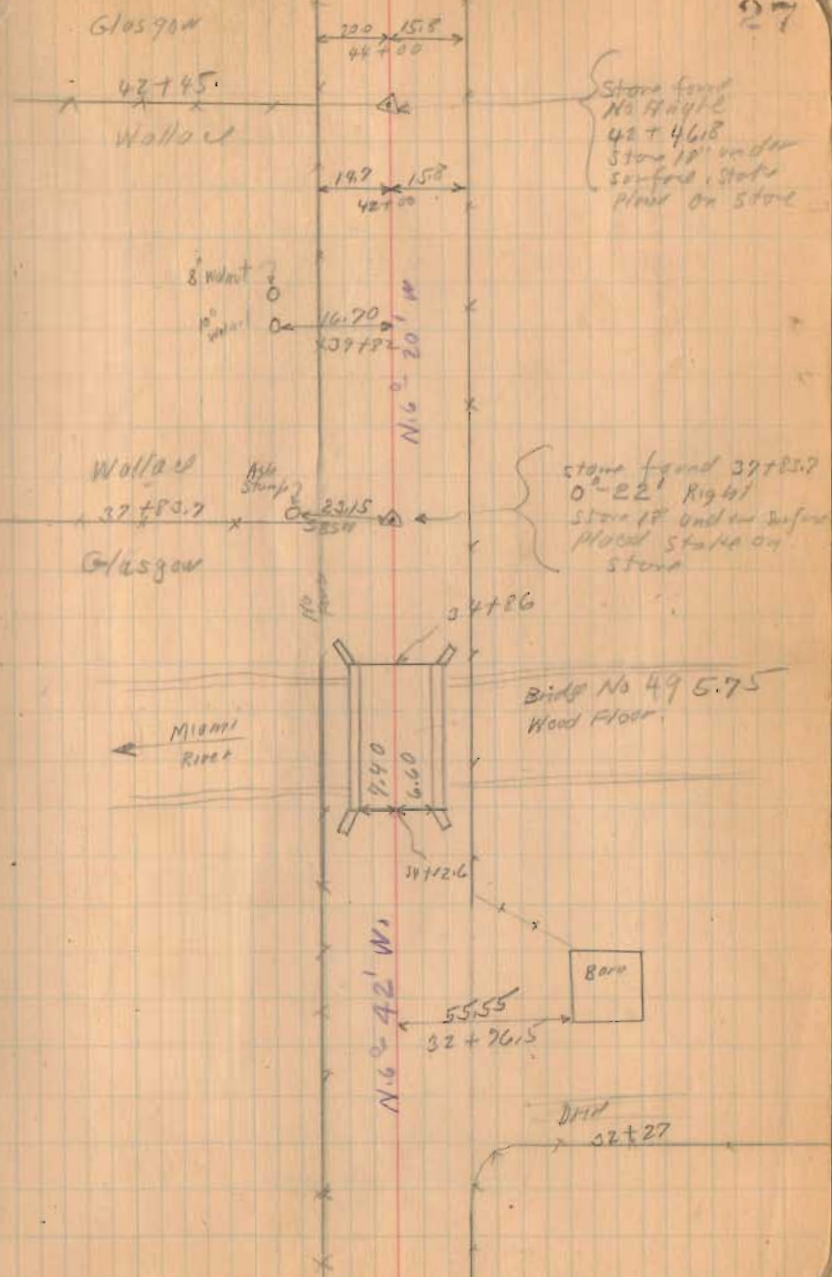

Road. 49

1371
INDEXED ON MAP

