

Road No. 9
Rushbrook Twp

Stakes Placed 30' from E




Staked 5/18/32 Page 78 and 79

Staked 5/18/32 from Road 118
Sta (0+00 To 20+01)

(See Book 578 Page 26)

1379
INDEXED ON MAP

May - 15/32 ✓
New day 77
Wright
M. J. K. K. K.
D. H. H.

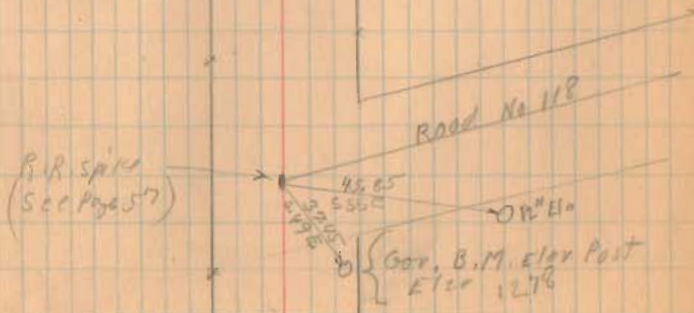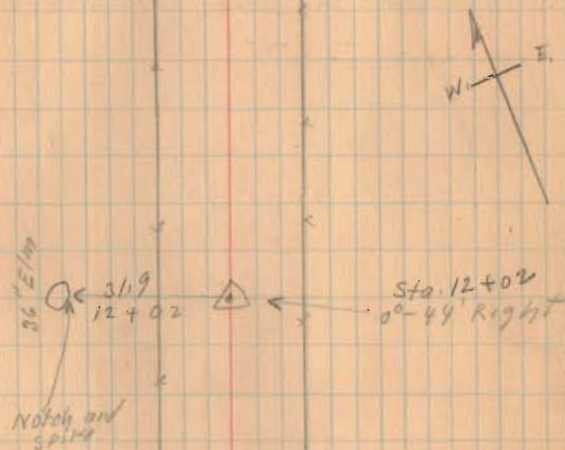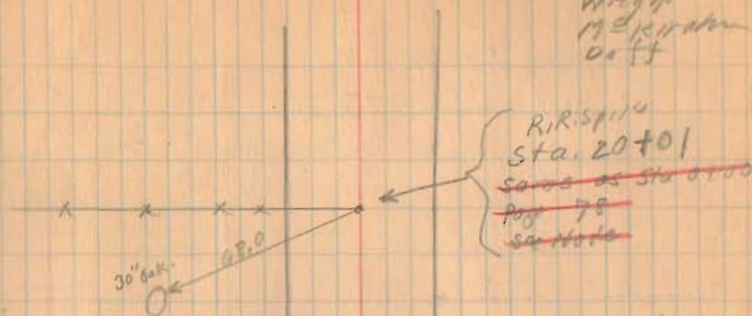

Road No. 9
 Rusherick Trwp
 Bellefontaine - Rushsylvania Pike.


stakes found 30' from E for 60' Road.

60' see Bellefontaine - Rushsylvania
 Pike Free Turnpike Record
 No. 3 Page 360

(1379)

INDEXED ON MAP

May - 18 - 1932
 Clear
 Cool
 Windy
 in afternoon
 Duff

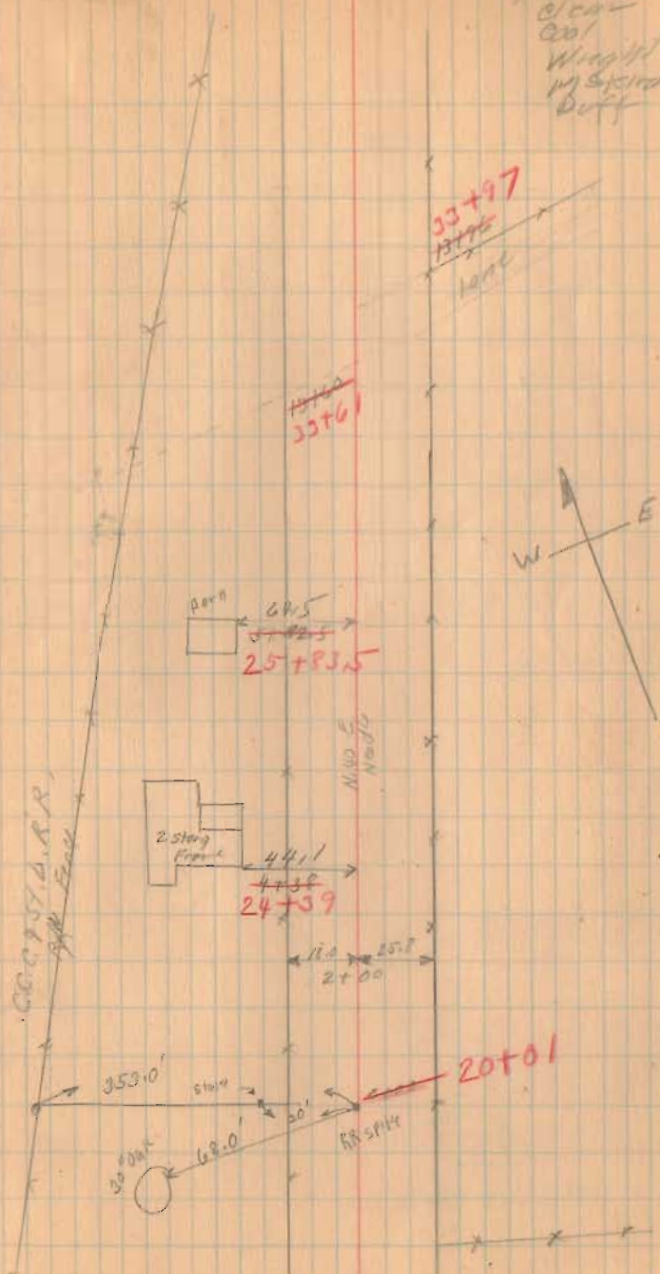

Road. 9

1379

INDEXED ON MAP

4/10/52

79

