

Road, 116

Rushorak Twp.

No Road Record Found.

Stakes 20' from E for 40' Road

For Monuments

11700


5700

1700

1699

INDEXED ON MAP

Dec. 16, 1935
C. O. W. W. W.
E. W. W.
E. C. W.
G. W. W.

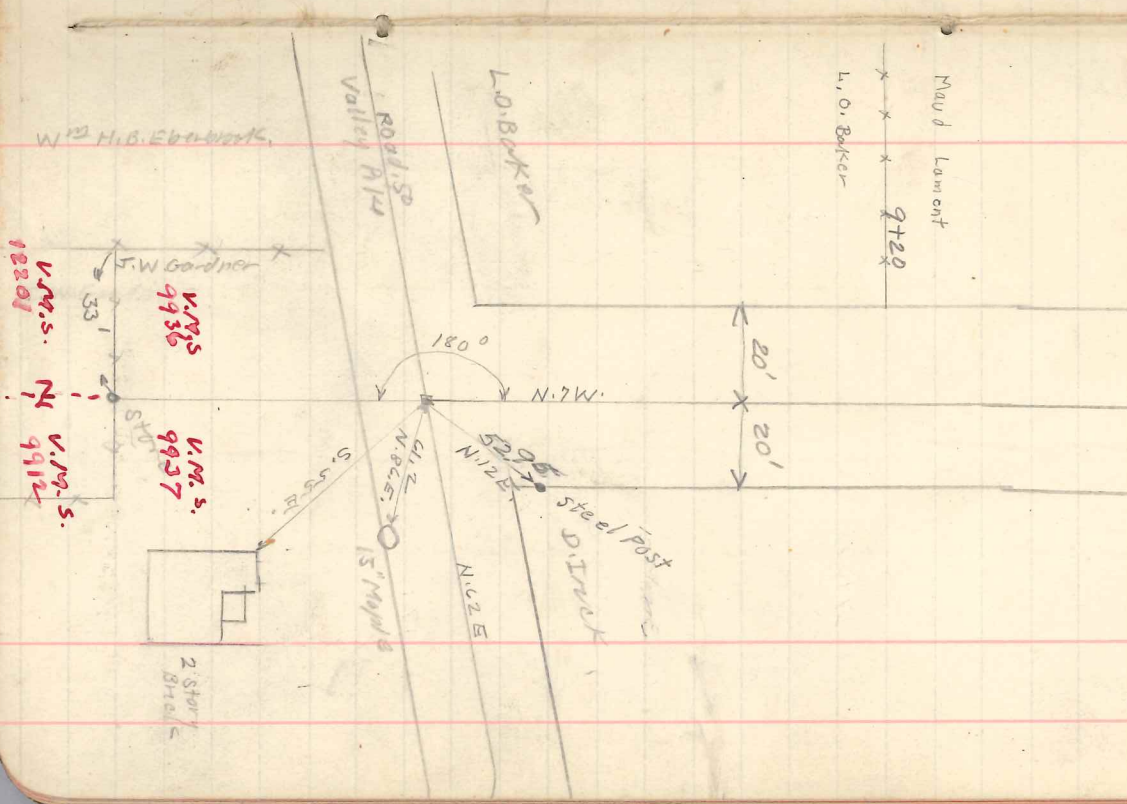

Road 116


27+00

25+00

17+00

INDEXED ON MAP

1699

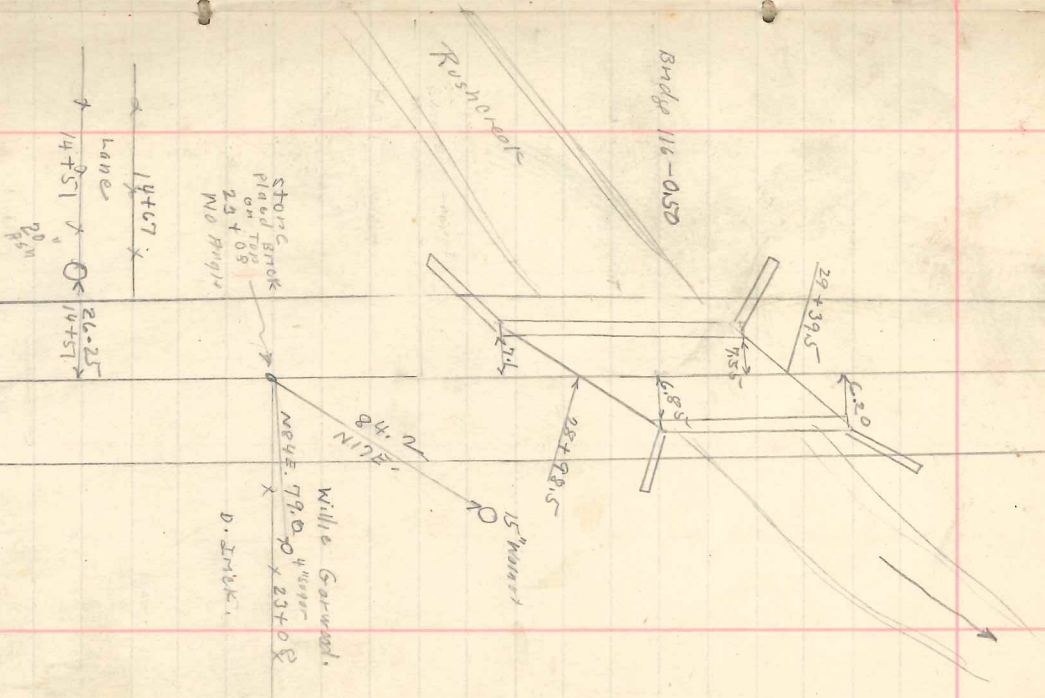

12-10-31

Road 116

77+00

73+00

69+00

65+00


61+00

(see note page 68)

INDEXED ON MAP

699

Dec 12, 1935
Snowing
F. W. Wright
E. Carr
G. W. Briggs

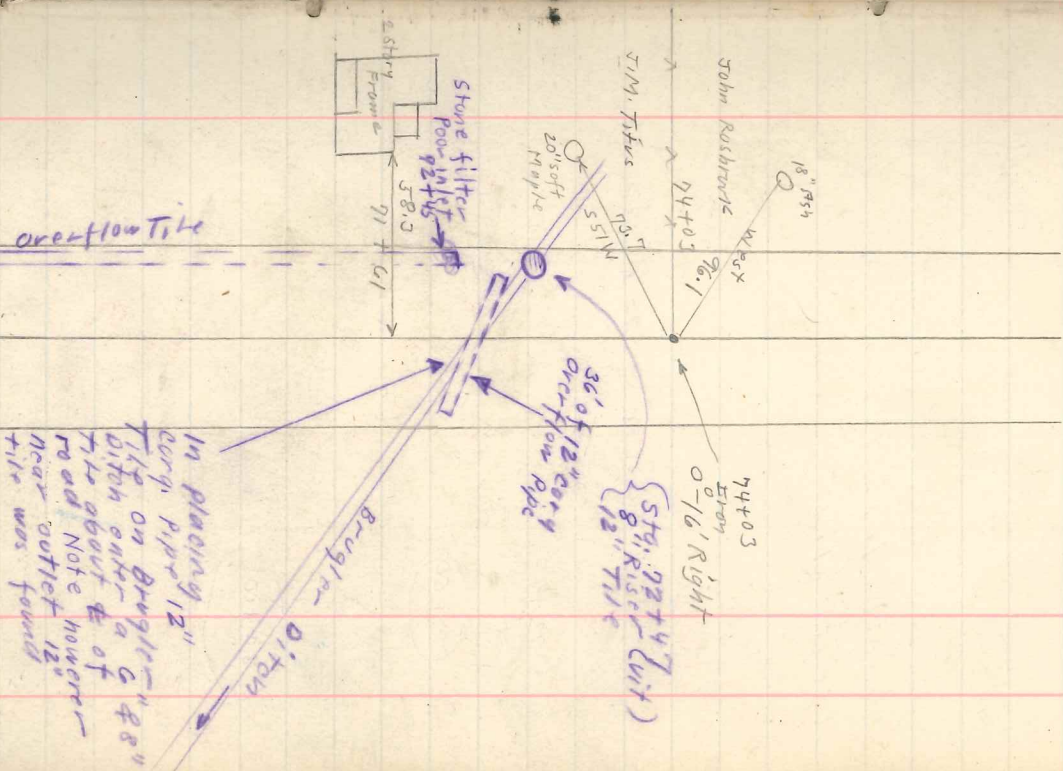

In placing 12" corr. pipe 12" TIE on Burgin 48" ditch enter a G 48" TIE about 4' of road. Note however - near outlet 12" TIE was found

