



Irick-Selck Survey  
 VMS 9937 Rushcreek Twp.

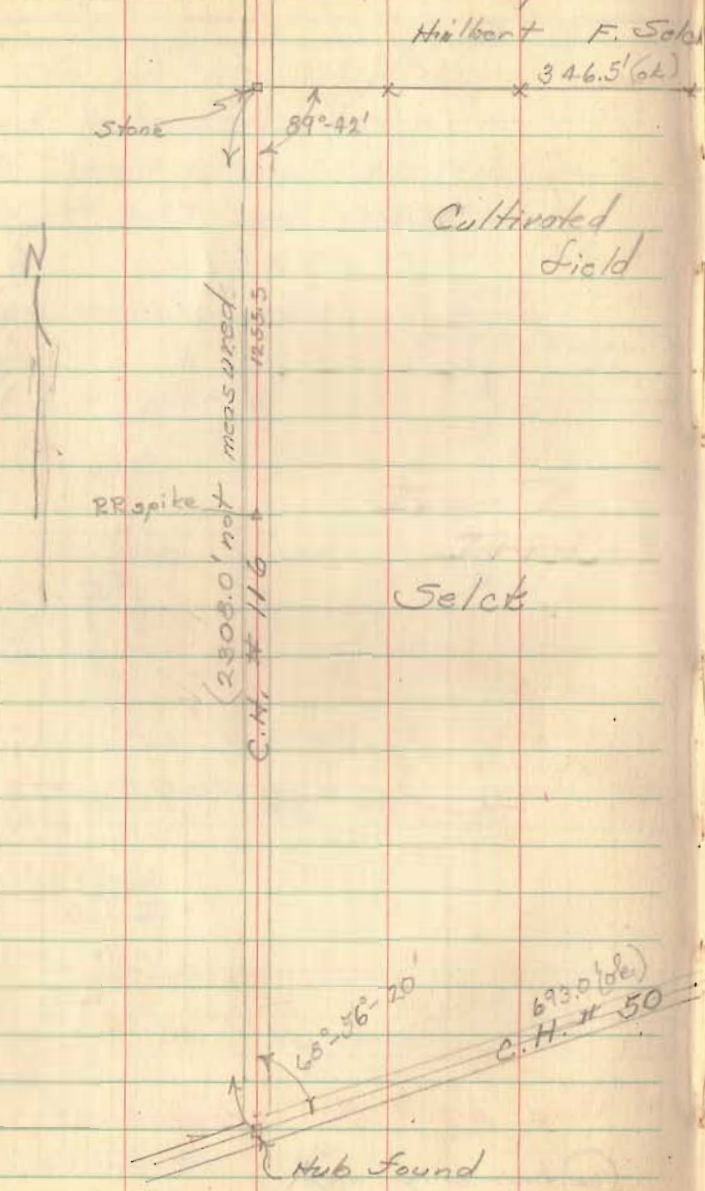

Party: - C. Keyser  
 D. Dullson  
 V. Detrick  
 N. Keyser

May 10, 1949.

73

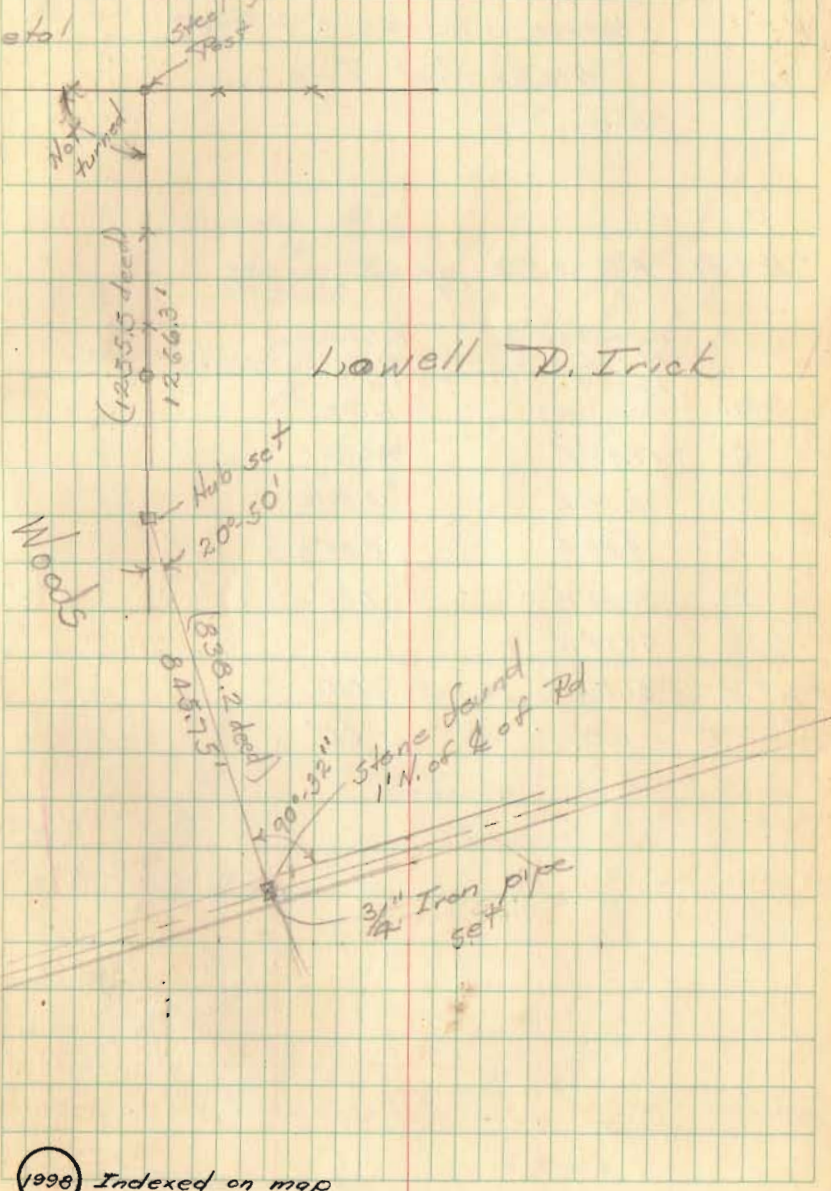

1998 Indexed on map