


Bridge 12-555

Party
C. Kousor
G. Williams
P. Lyons
M. Regier

22 Nov 46
Cold-Windy 31

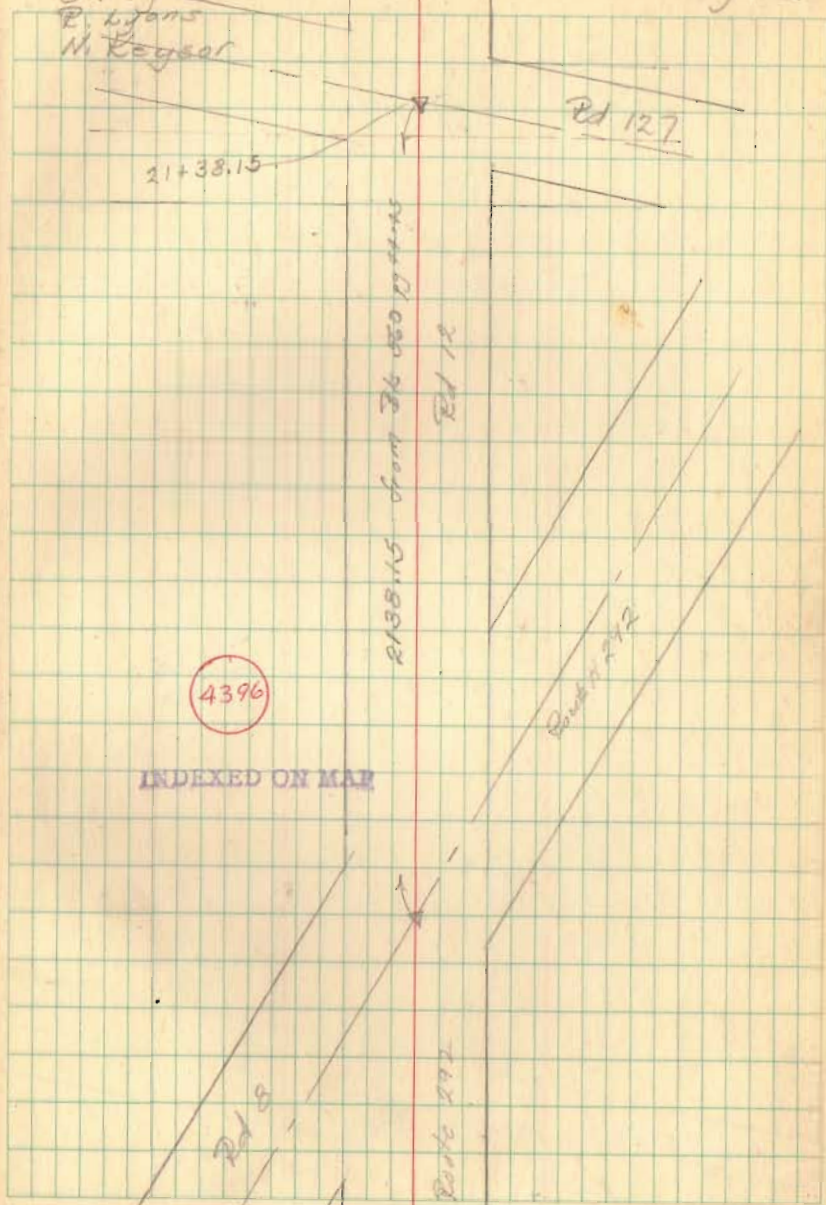

Bridge 12-5.55 (cont'd)

22 Nov 46 32

RR spike
41+70.6

Iron
41+38.5
sec 8657A
pg 29

Rd 127

