

Note:
 ○ Iron Bars
 ● Stakes

Auditors office
 Transferred 8-18-1910
 W. J. Jones
 Co Auditor

CAMP RUSSELL ALLOTMENT

SEC. 36 T 6 R 8 WASHINGTON TP. LOGAN Co.
 SURVEYED AUG. 29, 1910
 Fred W McKinnon
 Deputy Co. Surveyor

RECORDERS OFFICE
 Received for Record 2 o'clock P.M. Aug 18

Henry Kemper
 Co. Recorder

Recorded Plat Book B Page 13

Note:-
 This tracing was copied from the original tracing which was badly worn and torn. Some of the figures were not legible.
 J. J. Wright, Oct. 6, 1932

See Book 390-A Page 1 for Field Notes

1910 - Aud. Recp.
 3.60 acres transferred to Lots
 Pencil Figures from Field Book


J-4

J-4


J-4
 How

INDEXED ON MAP

CAMP RUSSELL ALLOTMENT
 SEC. 36, T-6, R-8, WASHINGTON TWP.
 RUSSELL POINT

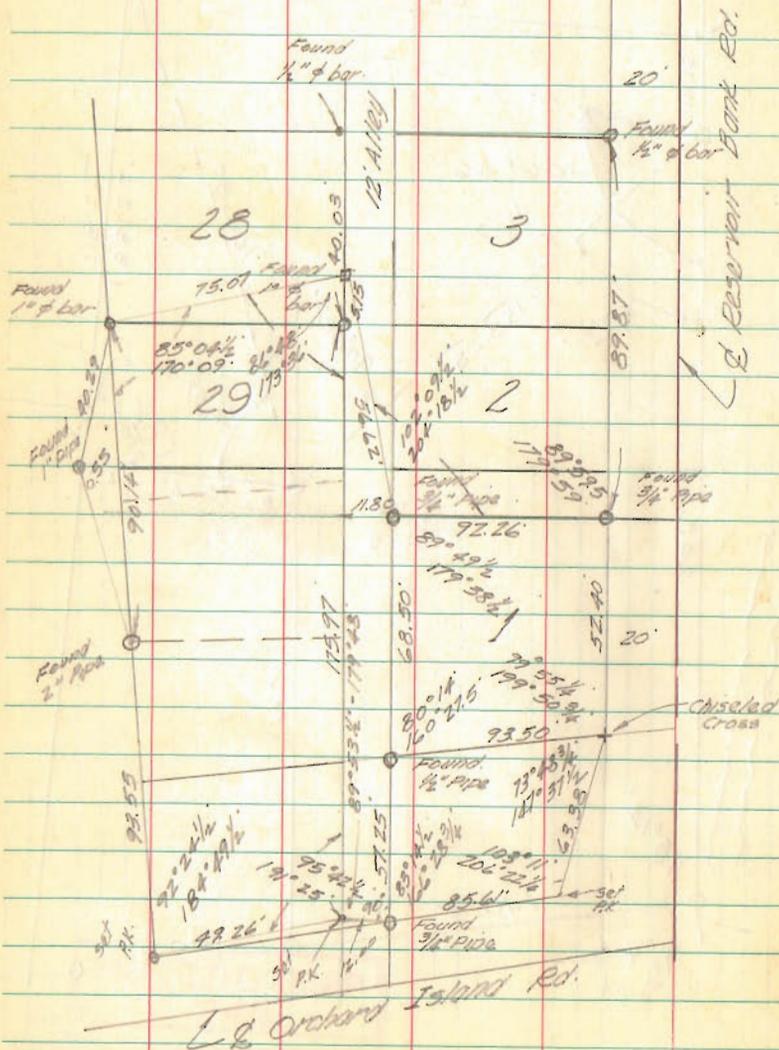

Sept. 9, 67
 Whitlow
 Attis

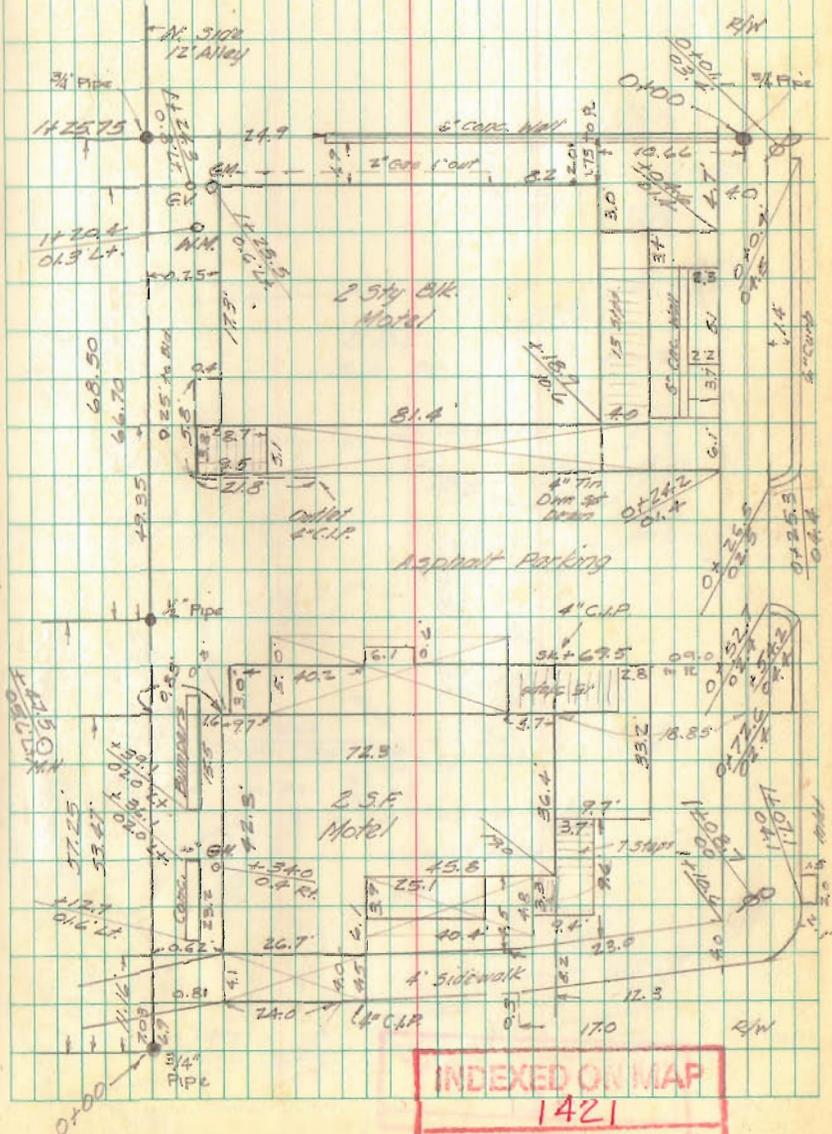

INDEXED ON MAP

1421

Camp Russell Louis
Russell's Point

- A = $\frac{3}{8}$ " ϕ Bar found in Pipe N.W. cor. lot 16
 B = $\frac{3}{2}$ " ϕ Bar with + found in conc. pavement
 C = P-K nail set
 D = $\frac{3}{4}$ " ϕ Bar found (lot owner says pin has been in same location since 1924)

projected A-B north 6.0' set P-K for Alley

projected \perp alley west 9.0' set P-K

projected line 9.0' W. of A-B, north 100.0

set P-K, turned $87^{\circ}43'$ to make

north line parallel of alley -

Calc. dist. to move "C" to make angle

= $90^{\circ}55' = 5.91'$ set temporary

point @ $5.91 + 9.0 = 14.91 =$ N.W. cor. lot 15,

meas east 200.0 feet set point.

turned \angle to "D" = $90^{\circ}47'$ - moved

point 0.21' east to make $\angle = 90^{\circ}55'$

INDEXED ON MAP

1421

