


I HEREBY CERTIFY THAT THE ITEMS INDICATED ON THIS PLAT HAVE BEEN CONSTRUCTED AND ARE HEREBY APPROVED.

APPROVED	DATE	APPROVED	DATE
<i>Chester R. Kurtz</i>	11/18/70		
<i>Chester R. Kurtz</i>	12/8/70		
<i>Chester R. Kurtz</i>	2/1/71		
<i>Chester R. Kurtz</i>	11/26/71		

TO ALL PERSONS INTERESTED IN THE TITLE TO THE PREMISES SHOWN ON THIS PLAT PLAN.  
 I HEREBY CERTIFY THAT I PERSONALLY MADE AN ACTUAL SURVEY OF THE PREMISES SHOWN ON THIS PLAT PLAN ON THE 27<sup>th</sup> DAY OF November 1971, AND THAT THIS PLAT PLAN IS A CORRECT REPRESENTATION OF THE PREMISES AS DETERMINED BY SAID SURVEY. I FURTHER CERTIFY THAT THERE ARE NO ENCROACHMENTS EITHER WAY ACROSS ANY BOUNDARY LINE OF THE PREMISES EXCEPT AS SHOWN HEREON.  
 SIGNED AT HUNTSVILLE, OHIO THIS 21<sup>st</sup> DAY OF December 1971

*Chester R. Kurtz, P.E.*  
 REG. SURVEYOR No. 4849

EXHIBIT "B"  
 THIS EXHIBIT SHALL BE CONSIDERED A PART OF AND SHALL BE USED IN CONJUNCTION WITH EXHIBIT "A"

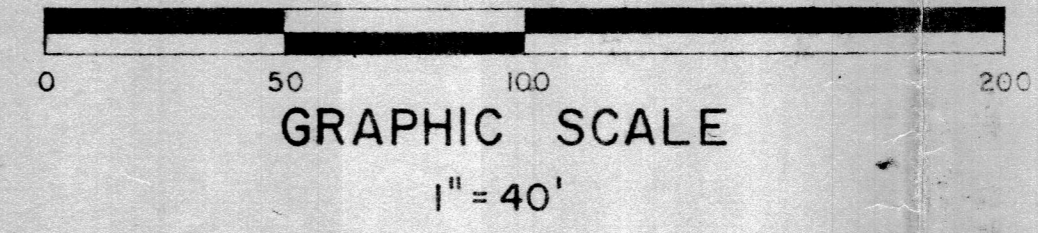

CHESTER R. KURTZ, P.E.  
 OHIO NO. 27915  
 HUNTSVILLE, OHIO