

Part Lot 1095  
Russells Point  
July 5, 1973


The following described real estate situated in the Village of Russells Point, Washington Township, Logan County, Ohio and being part of Lot 1095 of Harbor View Allotment as shown on Logan County Recorders Plat Book 3, Volume C, Page 71 and also part of Lot No. 46-173 as shown on Logan County Recorders Plat Book 5, Volume E, Page 17 and being more particularly described as follows:

Beginning at an iron pipe in the center of Harbor View Drive at the northwest corner of said lot 1095; thence with the center-line of said drive and the north line of lot 1095 S. 70° 45' E. 37.9 feet to an iron bar; thence S. 23° 37' W. 107.8 feet to a chiseled cross on a concrete wall on the south line of lot 46-173, passing an iron bar at 100.0 feet; thence with the south line of said lot 46-173, N. 63° 34' W. 5.2 feet; thence with said south line N. 78° 56' W. 33.1 feet to the southwest corner of said lot; thence with the west line of said lot 46-173 and the west line of lot 1095, N. 23° 37' E. 111.6 feet to the place of beginning, passing an iron bar at 11.6 feet.

The above described tract being part of lot 1095 and 0.017 of an acre out of lot 46-173.



HARBOR VIEW DRIVE 30'  
 N. 70° 45' W.

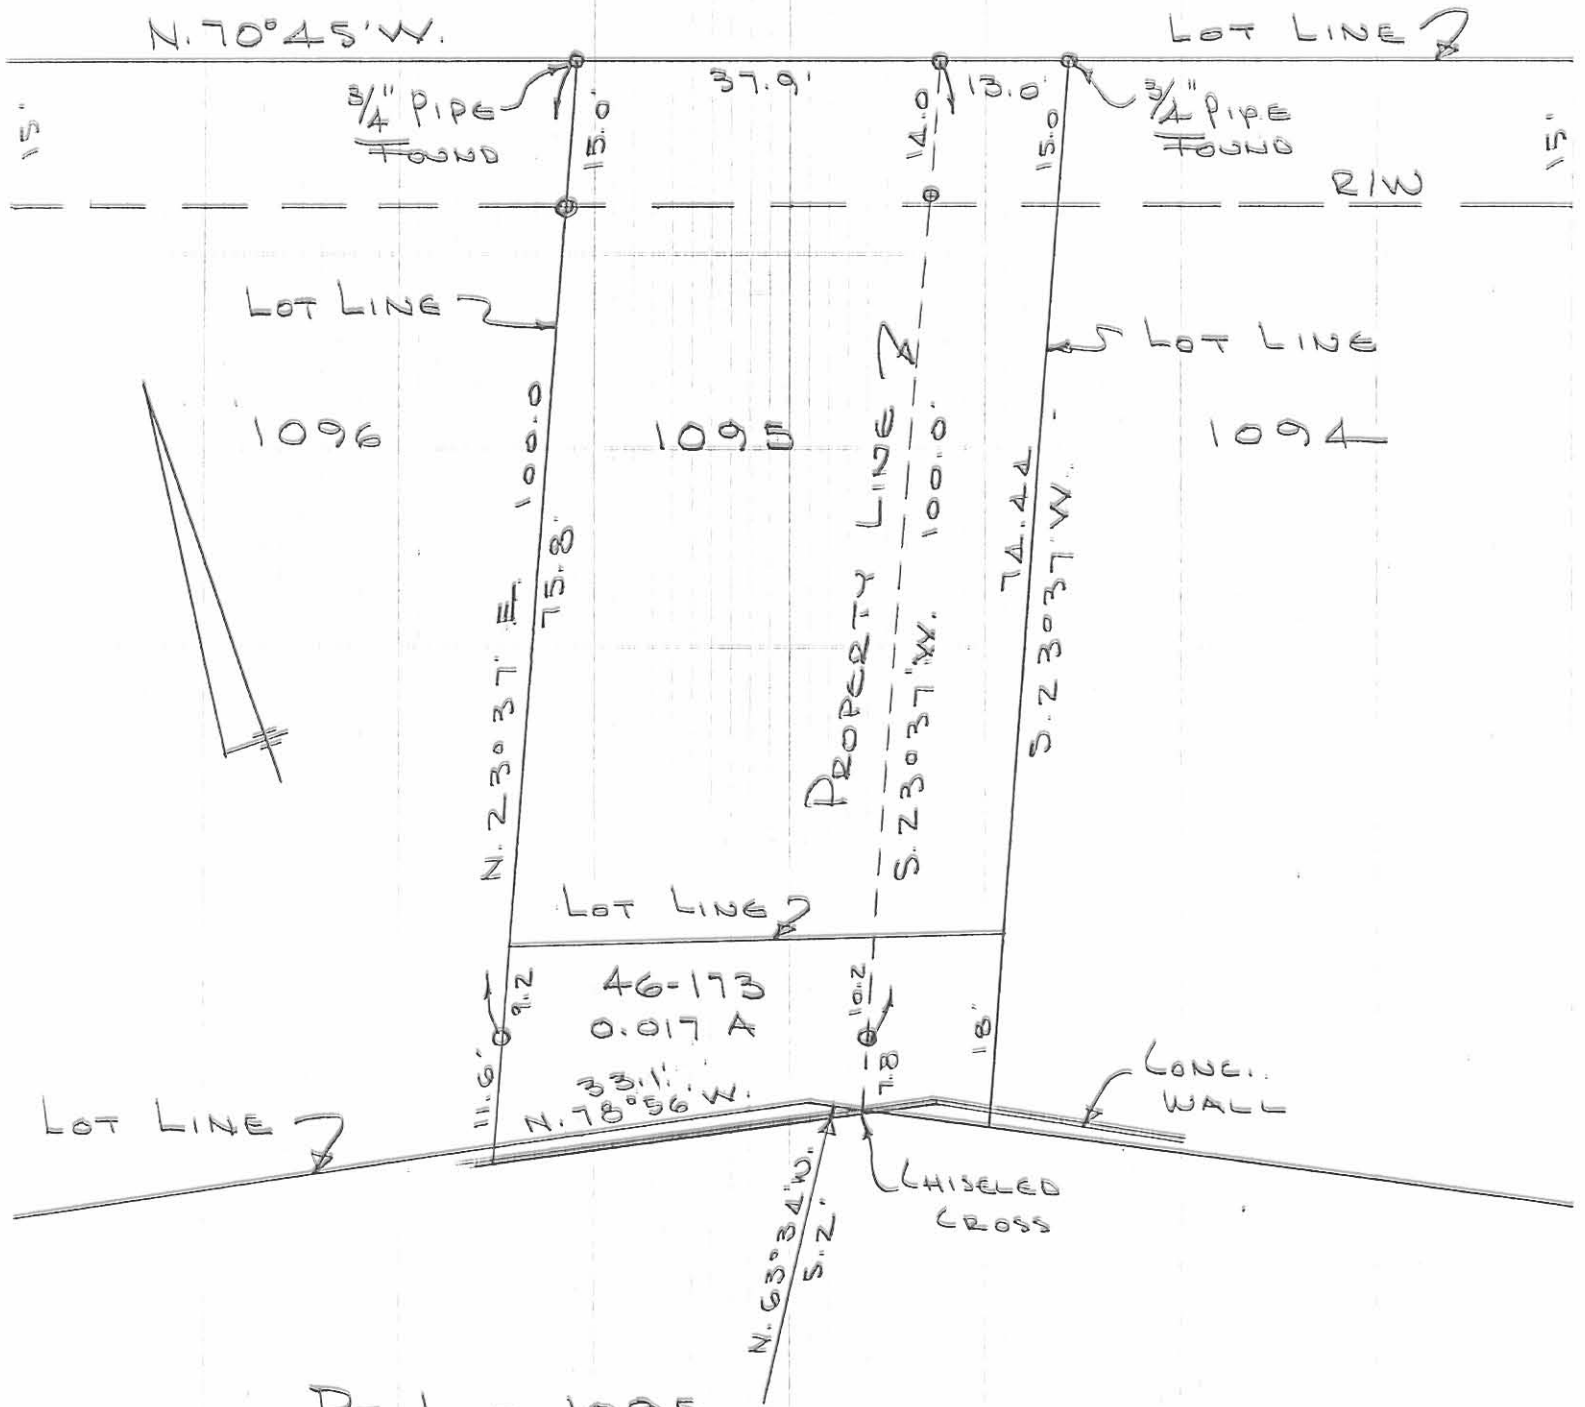

Pt. Lot 1095  
 RUSSELLS POINT, OHIO  
 JULY 12, 1973  
 SCALE 1" = 20'  
 O = 5/8"  $\phi$  BAR SET

INDEXED ON MAP  
 5492 1P

DAN L. DOOSON  
 REG. SURVEYOR 4270  
 BELLEFONTAINE, O  
 BL. 20/