

SURVEY OF
 LOT 498 - 499 PART

RUSSELLS POINT, OHIO

JUNE 1, 1974

SCALE 1"=20'

5668 IP

DAN L. DOBSON
 REG. SURVEYOR 4270
 BELLEFONTAINE, O
 BK 20/56

INDEXED ON MAP

Lot 498
Russell Point

- A = R.R. Spk Found S. line Van Buren St
 B = " " " 3" deep - 1" ϕ Bar at
 Surface 0.1 E & 0.1 N.
 C = 1" ϕ Bar Found 12" Deep - Leaning South
 D = 1" ϕ Bar Found
 E = Pipe Found ?
 F = 1/2" ϕ "


INDEXED ON MAP
5688

Dodson
Artis
McWardy

5/18/74

56

o = P-2 no. 1 set on E

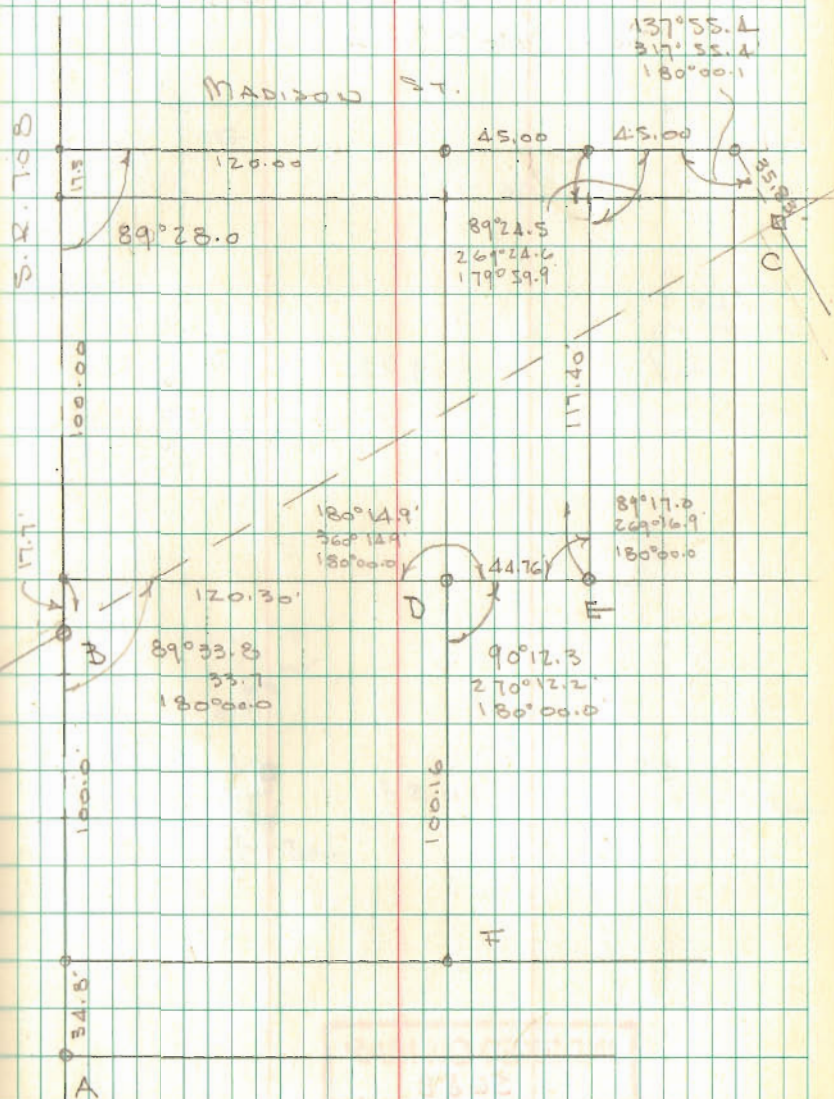


Lot 498 . Contd

G = Hub & Pipe found 0.1' N. & 0.1' E.
Set $5/8"$ bar

Dodson
Arch's
McCurdy

June 1, 1974

57

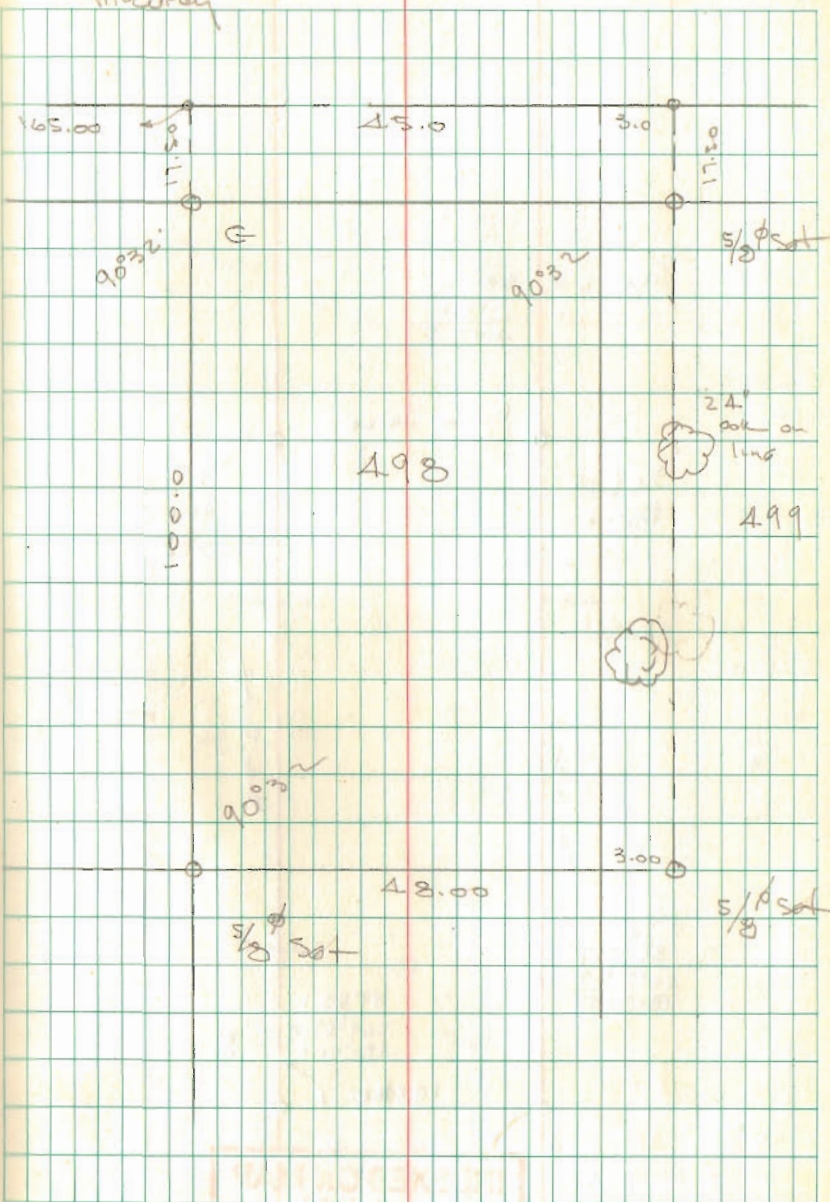

INDEXED ON MAP

5688

INDEXED ON MAP
1000