


ELLIOTT ROAD

R.R. SPIKE Fd.

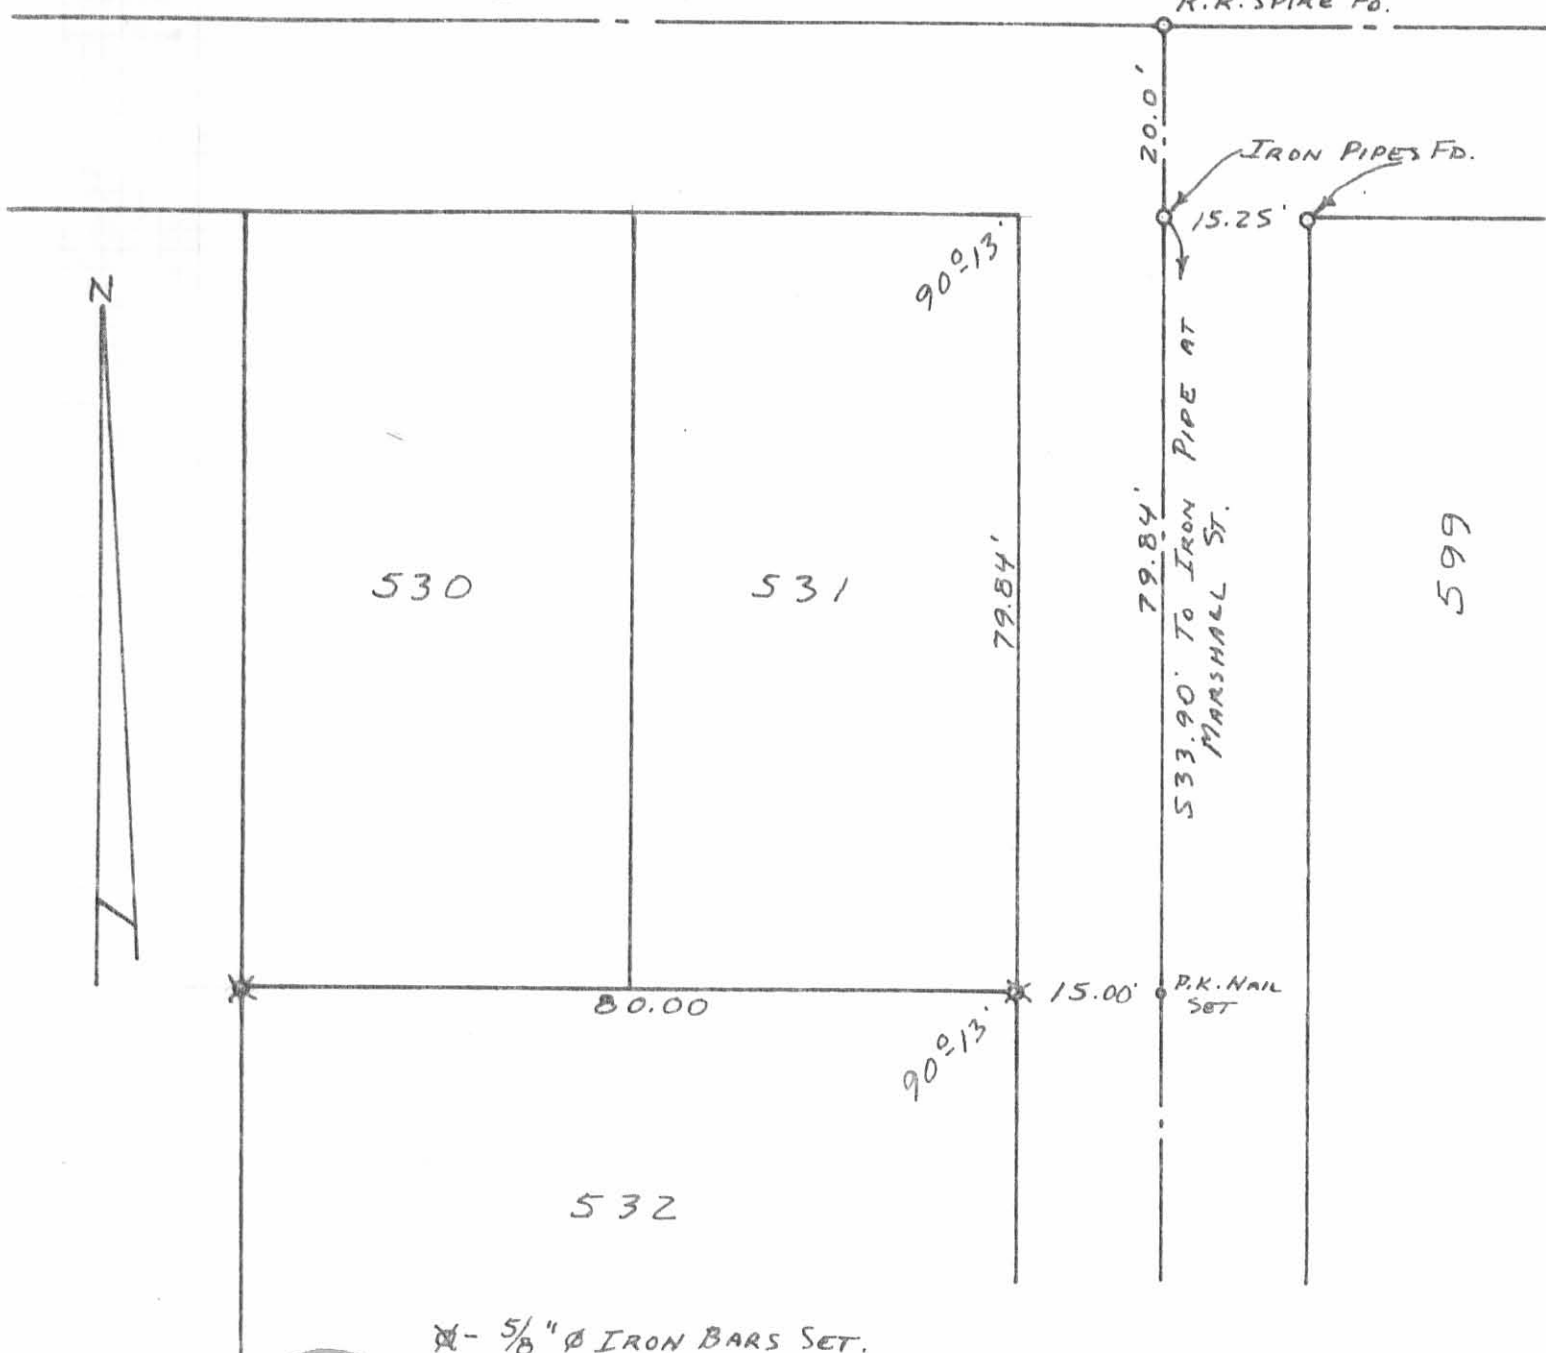

* - 5/8" Ø IRON BARS SET.

6591 IP

INDEXED ON MAP

SURVEYED AND PLATED BY:
 DANIEL E. GILBERT, P.S.
 REG. SUR. NO. 5402
 1041 N. MAIN ST.
 BELLEFONTAINE, OHIO 43311

M^c COMBS SURVEY
 LINE BETWEEN LOTS 530,
 531 AND 532
 VILLAGE OF RUSSELLS POINT
 WASHINGTON TOWNSHIP
 LOGAN COUNTY, OHIO
 JUNE 7, 1980

SCALE: 1"=20'