


SEWER & WATER LOCATION PLAN
 POINT VILLAGE
 RUSSELLS POINT, OHIO
 AUGUST, 1980
 SCALE 1" = 50'

Note: Int figures are as built, located
 May 2, 1981
 Elevations are as built using Point Village
 Datum which is 0.42 higher than U.S.G.S.
 Datum.

Dan L. Dodson
 Dan L. Dodson
 Reg. Surveyor 4270

PLAN PREPARED BY
 DAN L. DODSON
 REG. SURVEYOR 4270
 BELLEFONTAINE, OHIO

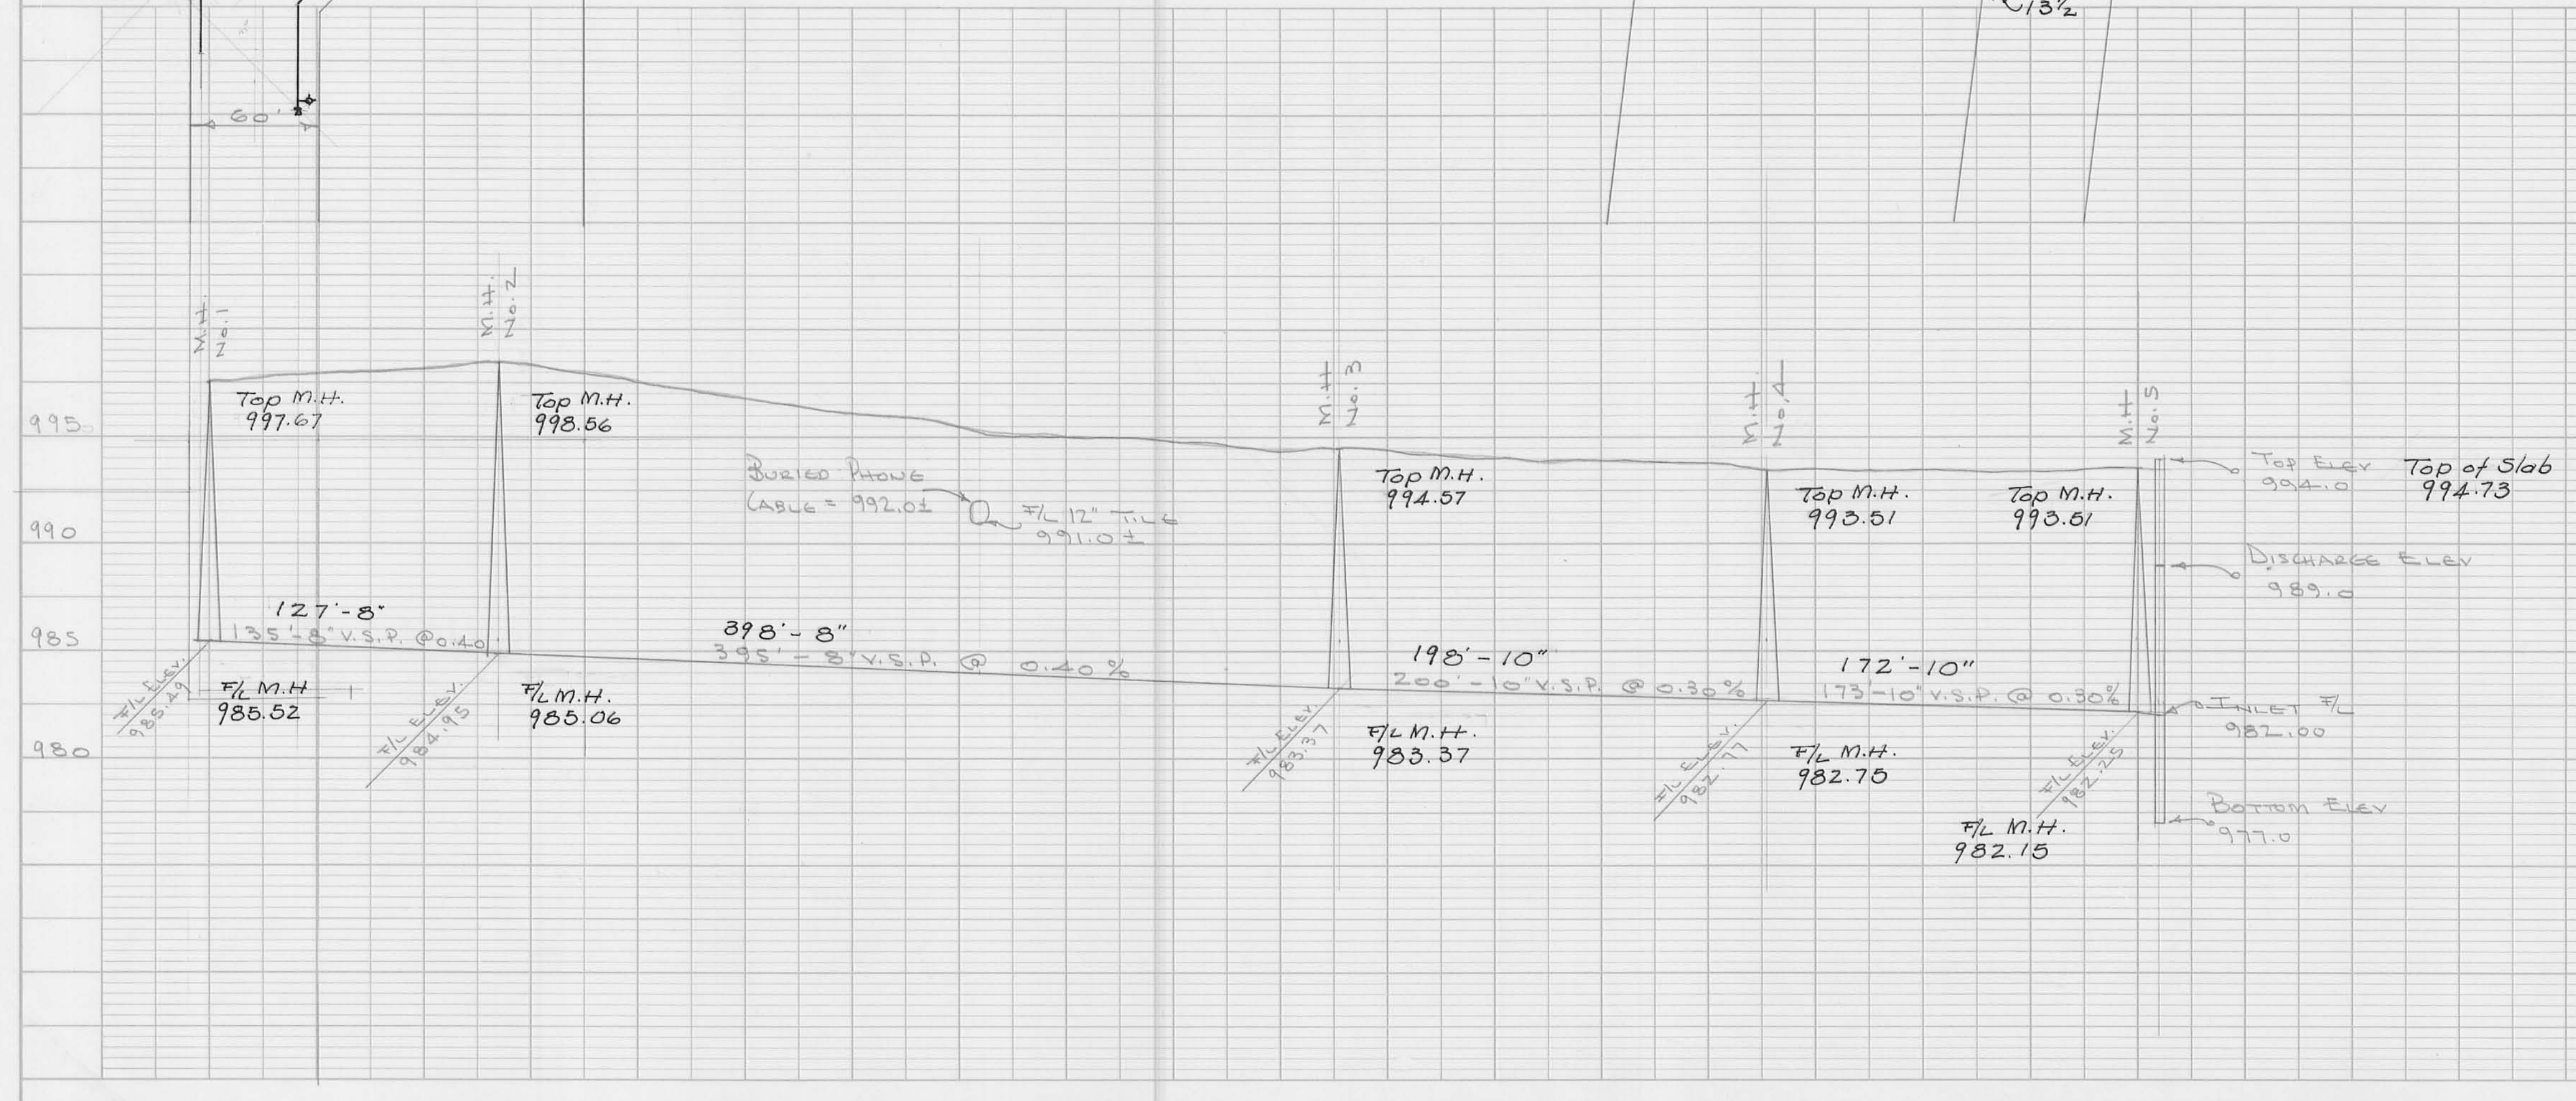

PLAN
 SURVEYED BY: _____
 NOTE BOOK: _____
 GRADE CHECKER: _____
 & M.A.'S NOTED: _____
 STRUCTURE INDICATIONS CHECKED: _____

PROFILE
 SURVEYED BY: _____
 NOTE BOOK: _____
 GRADE CHECKER: _____
 & M.A.'S NOTED: _____
 STRUCTURE INDICATIONS CHECKED: _____