


LEGEND:

A = 3/4" IRON BAR FD.

B = 1" PIPE FD.

C = 5/8" IRON BAR SET

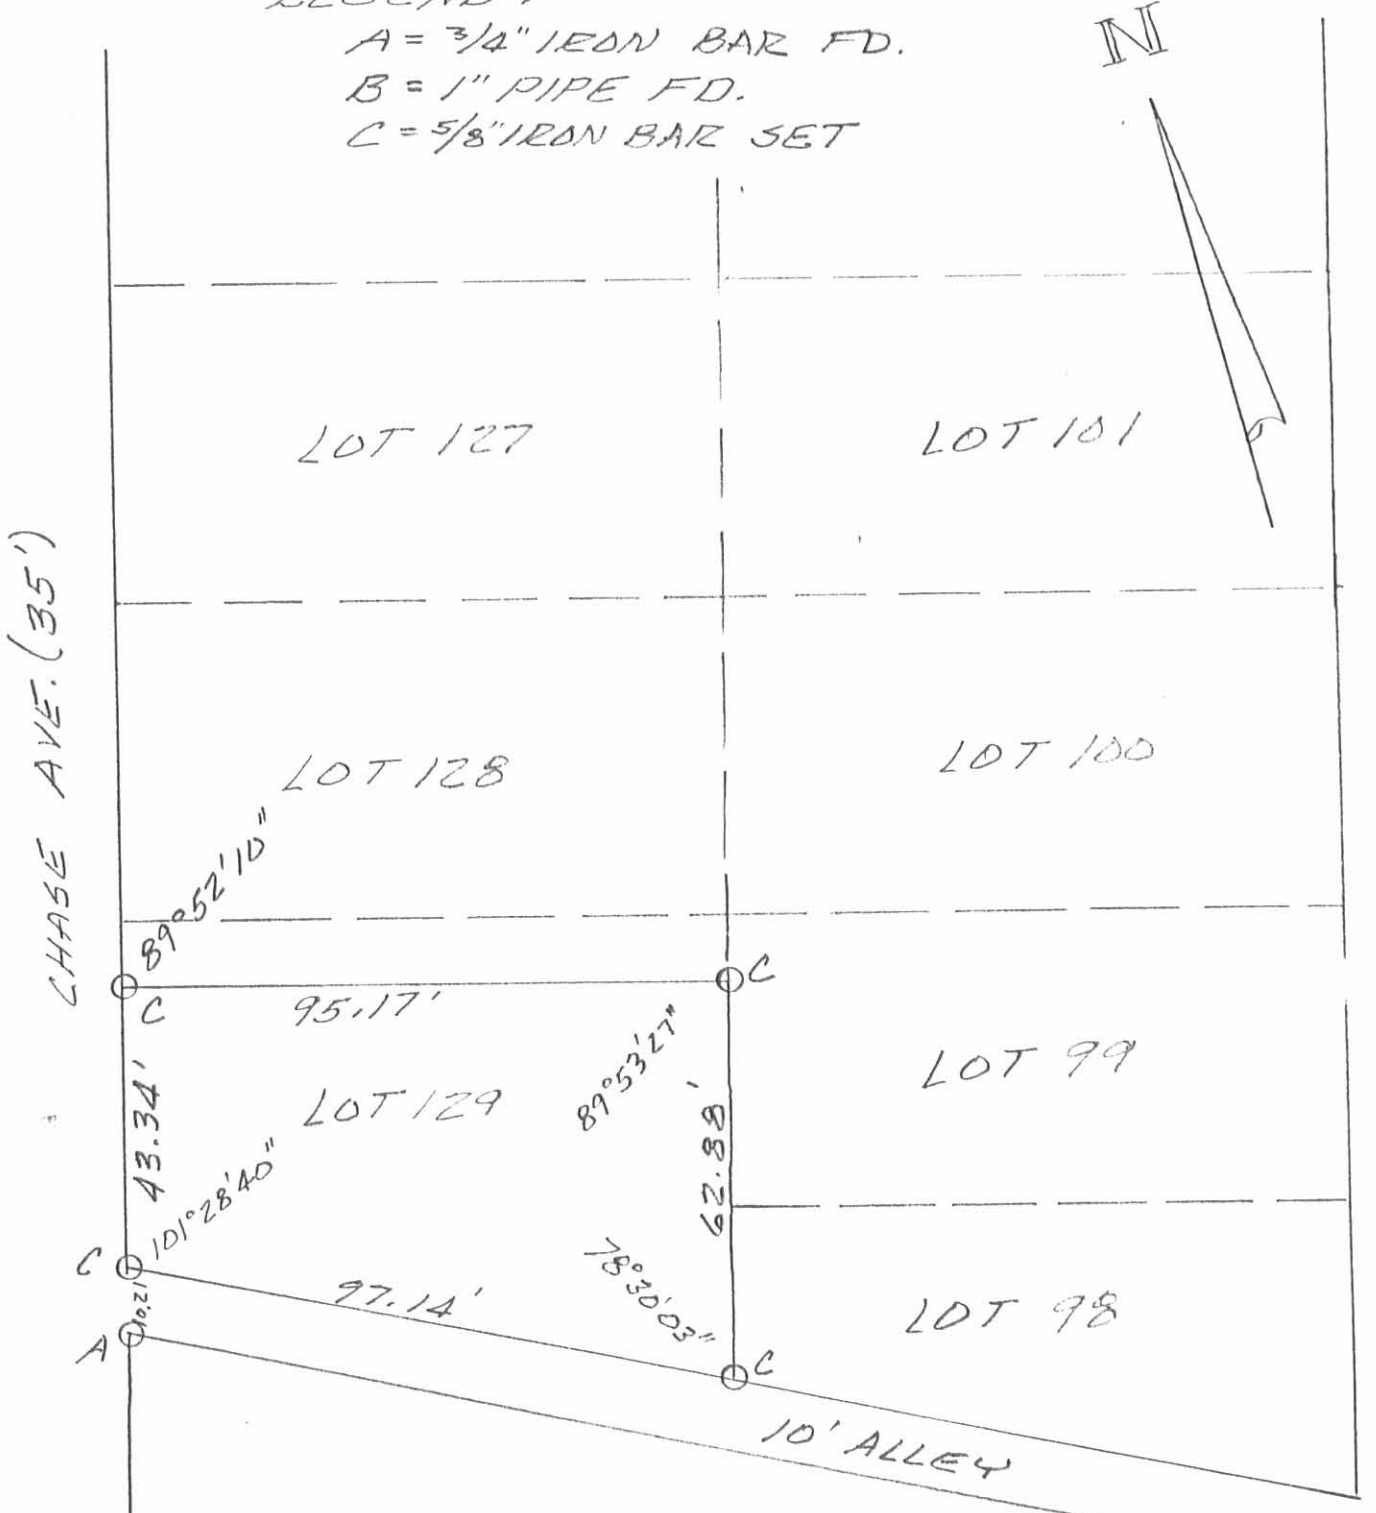

SURVEY OF LOT 129 EXCEPT 10'
 OFF NORTH SIDE IN CAIN PARK
 ADDITION TO RUSSELLS POINT,
 OHIO FOR COLONIAL FEDERAL
 SAVINGS & LOAN ASSOCIATION.
 JUNE 15, 1989
 SCALE: 1" = 30'



Leslie H. Geeslin
 LESLIE H. GEESLIN
 RUSHSVANNA, OHIO

INDEXED ON MAP
 7921 IP