


LEGEND

- ⊕ 3/4" SQUARE 1. ROD FOUND
- 1/4" X 1" BAR FOUND
- 3/4" 1. ROD FOUND W/ LOGAN COUNTY ENGINEER CAP "1981"
- 1" PIPE FOUND
- 5/8" 1. ROD SET

REFERENCES:

LOGAN COUNTY ENGINEER'S RECORDS:
 F.B. 709. PP. 8 & 9
 F.B. 705. PG. 3
 R FILE: 5061. 4752

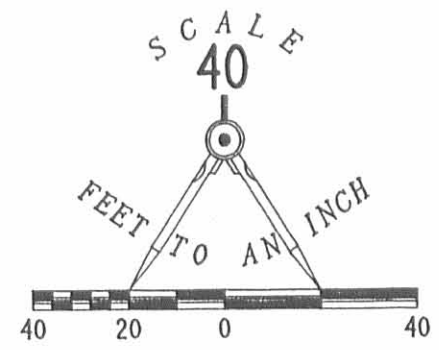

**RETRACEMENT SURVEY OF LOT 422
 (LOT 58. ADDITION TO SPRING GROVE ALLOTMENT)
 SECTION 36. TOWN 6. RANGE 8
 VILLAGE OF RUSSELLS POINT
 WASHINGTON TOWNSHIP
 LOGAN COUNTY, OHIO**

INDEXED ON MAP
 8847 1P

SURVEYED BY:

 JEFFREY I. LEE
 PROFESSIONAL SURVEYOR 6359
 OCTOBER 21, 1993



LEE SURVEYING & MAPPING CO.
 143 East Columbus Avenue
 BELLEFONTAINE, OHIO 43311
 (513) 593-7335

2 WORKING DAYS
BEFORE YOU DIG
 CALL TOLL FREE **800-362-2764**
 OHIO UTILITIES PROTECTION SERVICE.