


Auglaize Co.
Sec 10 T6 R8

540
INDEXED ON MAP

Sec. 10 T6, R8.

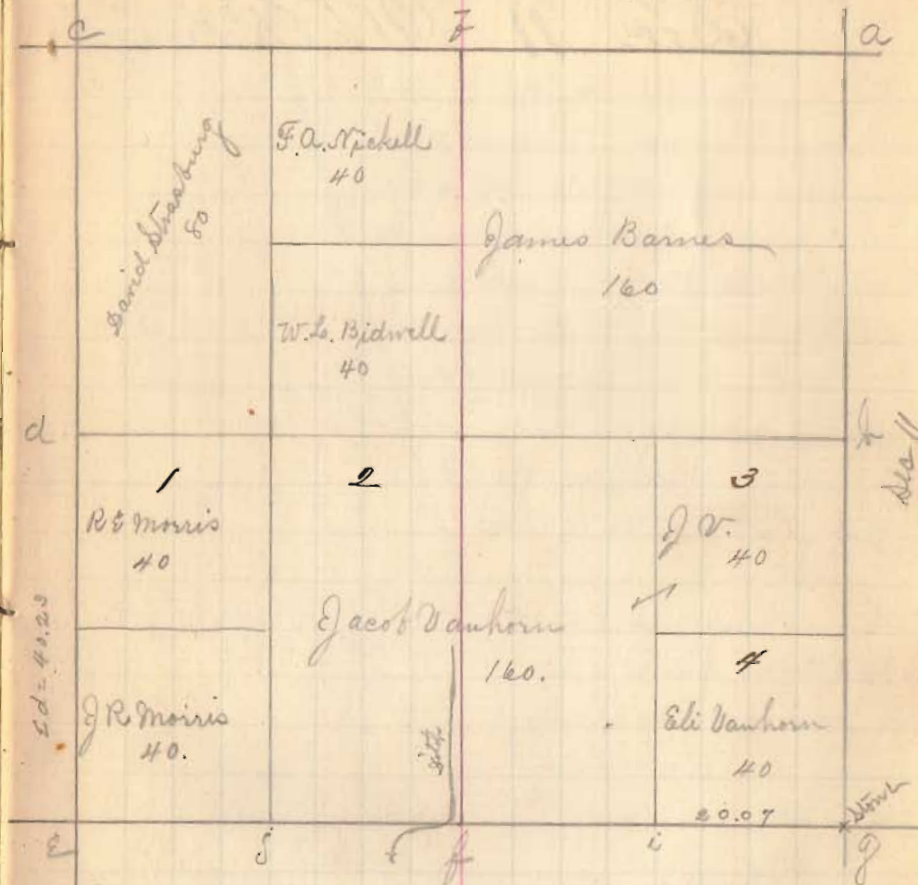

Mar. 27-85. Start at stone at c g
 20.07 enter fence north from c i,
 60.40 = j cut fence N. no stone let it be recorded.
 80.57 to e = ang. 9° 57' 51" = 21.212 and N. back to S 6 W 40"
 also large stone in fence by old well back 16' or 50' = 11 29