

Watson Survey Island View
 Lot 123 and 122 Stokes Twp.
 V.M.S. 12276


See Book 385 for Wise Island View.
 See Book 480 Page 23 for Small Survey

- A. Hub found See Book 480 Page 24
- B. Hub found.
- D. Iron placed.
- E. Iron Found.
- F. Hub placed
- G. Hub Found.
- H. Temporary Point
- I. Hole in concrete (See Next Page)
- J. 1/2" Iron Placed.

INDEXED ON MAP
 1248

Oct. 6-1921
 Worm
 Wright

52

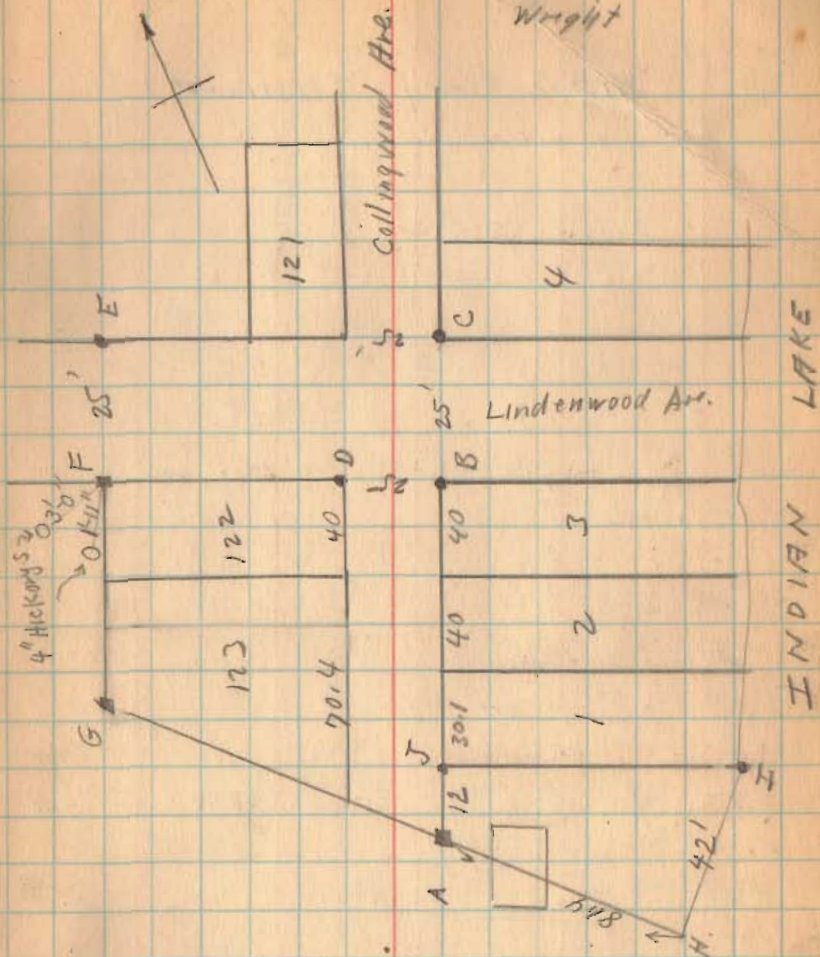

(See Next Page for witnesses)

Watson survey (Continued)

INDEXED ON MAP

1248

