


March 30 1935
F. Wight
E. core

73

Barns Survey
for
Lakeview Bank
V.M.S. 12277 Strakes Tap

See Book 588 Page 41 for survey Road 250

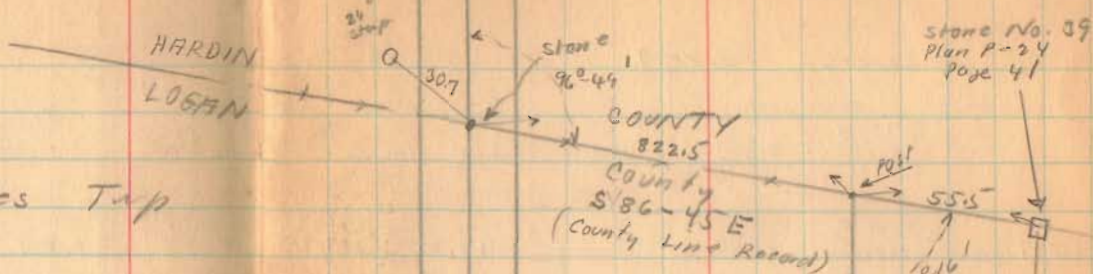


1132.0
N 3-34 W

17.31 Acres.

9970
S. P. - 31 W.

Strakes Tap
(No Eas.)
Richard Tap

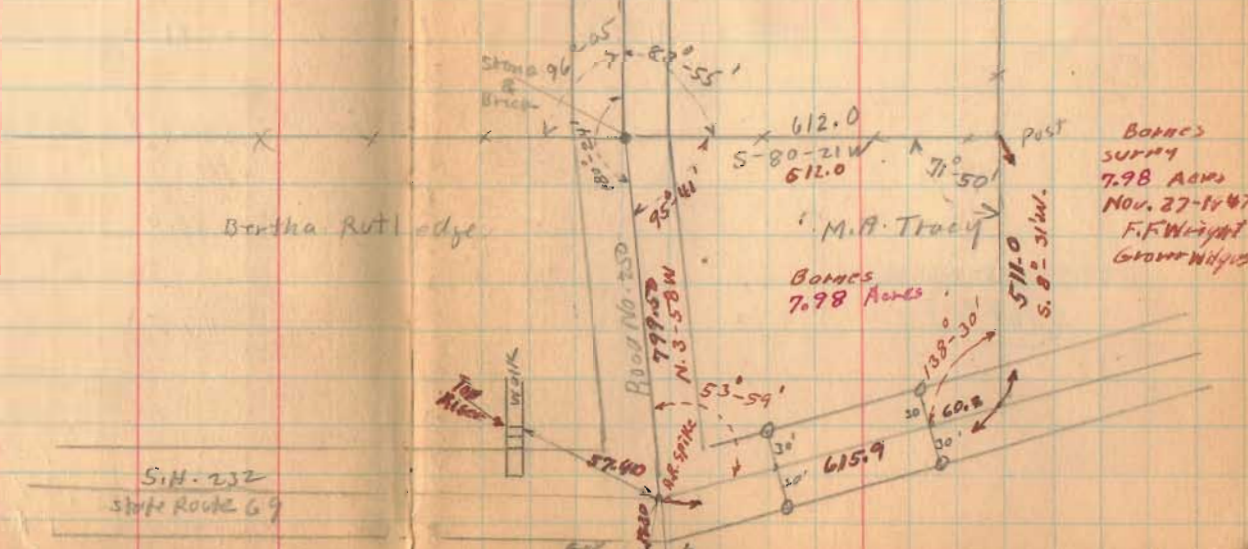

INDEXED ON MAP

(1642)

S.H. 232
State Route 69

Barnes Survey

Cosine	Bearing Dist	Sine	Lat (cosine)		Dist		Double Area (D.M.D. lat.)			
			N+	S-	E+	W-	D.M.D.	N+	S-	
.0567	S. 86-45 E 822.15	.9984		46.6	821.4 821.2			821.4		38,277
.9890	S. 8-31 W 997.0	.1481		986.0	¹⁴⁷ 147.7			1495.1		1,474,169
.1676	S. 80-21 W 612.0	.9858		102.4 102.6	603.0 603.0			744.4		76,227
.9981	N. 5-34 W 1137.0	.0622	1135.0 1134.8			70.7		70.7		80,245

1135.0	1135.0	821.4	821.4	80,245	1,588,673
1134.8	1135.2	821.2	821.7		80,245
(0.14)			(0.5)		2 1,508,428
				43520	7,542,214
					17,31407
					17,31 Area

INDEXED ON MAP

1642