


REC'D 6-30-05 SMJ OK

LEGEND

- MAG NAIL SET
- 5/8 INCH IRON ROD FOUND
- 3/4 INCH DRILL HOLE IN CONCRETE SET
- ⊕ 3/4 INCH IRON BAR FOUND

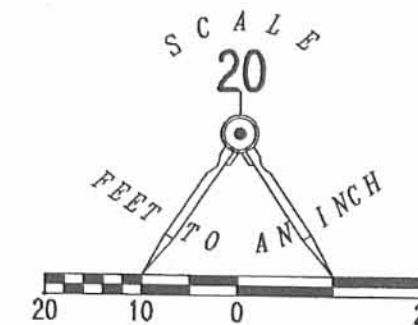

A RETRACEMENT SURVEY OF THE
 H. EVAN FORD, TRUSTEE OF KRISTINE M. FORD,
 LIVING REVOCABLE TRUST, DATED DECEMBER 27, 2001
 LOT 46-208
 INDIAN LAKE RESERVOIR LANDS
 PLAT CABINET A, SLIDE 451
 OFFICIAL RECORD 542, PAGE 804
 VIRGINIA MILITARY SURVEY 12276
 STOKES TOWNSHIP
 LOGAN COUNTY, OHIO



SURVEYED BY:

Jeffrey I. Lee
 JEFFREY I. LEE
 PROFESSIONAL SURVEYOR 6359
 JUNE 23, 2005



ORIGINAL STAMP IN GREEN

COPYRIGHT 2005 BY:
 LEE SURVEYING & MAPPING CO., INC.
 117 North Madriver Street
 BELLEFONTAINE, OHIO 43311
 (937) 593-7335

ADW D0605 40490605 L-40490605-3

2 WORKING DAYS
BEFORE YOU DIG
 CALL TOLL FREE 800-362-2764
 OHIO UTILITIES PROTECTION SERVICE

INDEXED ON MAP
 2521

-1P