


30' PRIVATE STREET

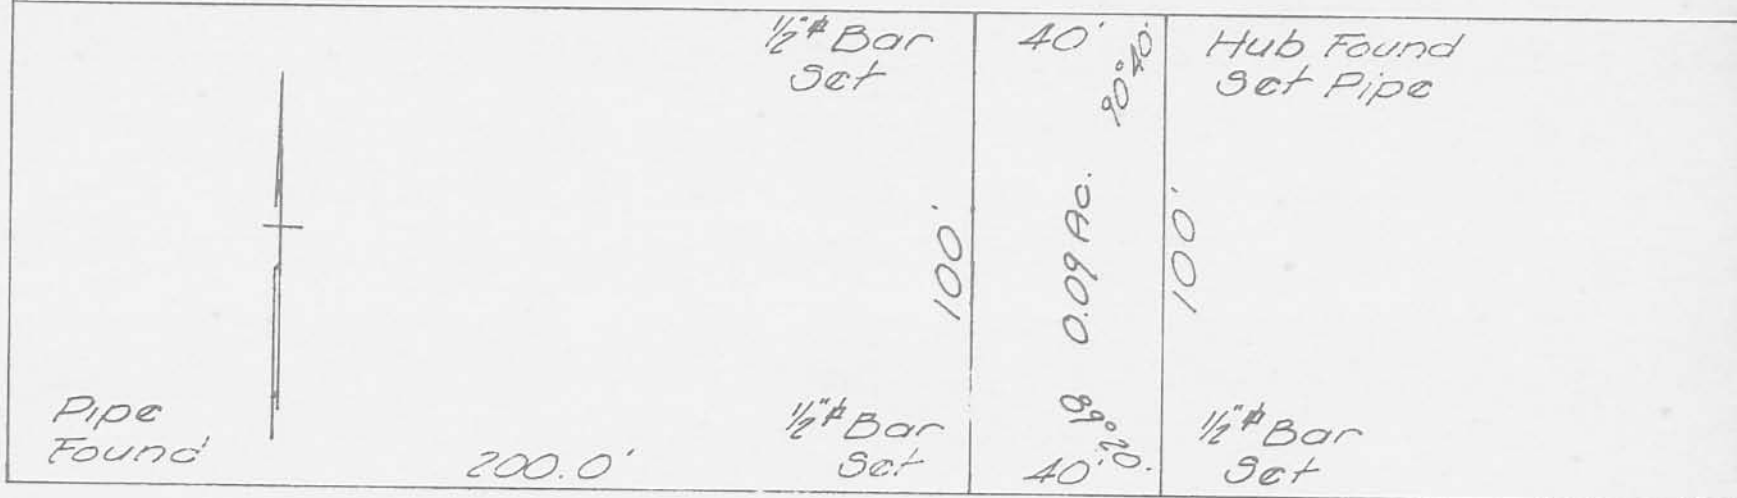

30' PRIVATE STREET

SURVEY FOR C.R. GRAHAM  
 H.L. WILLIAMS TRACT  
 SEC. 27 TOWN 6S. RANGE 8E.  
 STOKES TOWNSHIP  
 JUNE 11, 1963  
 SCALE 1"=40'

ON PLAT BOOK  
 3-31-64  
 D.E.G.



*Dan L. Dodson*

Dan L. Dodson  
 Registered Surveyor 4270 IP  
 Bellefontaine, Ohio

3647

INDEXED ON MAR