

FB 685

Road 92

2196

1700 Hub Set

0+00 Sta 516+44.8 & S.H. 33

June 6, 50

O. K. Shirk
N. Keysor
R. South


56

N 89° 50' E (Calc.)

4387

INDEXED ON MAP

Blanchard
Ward
1630' to E

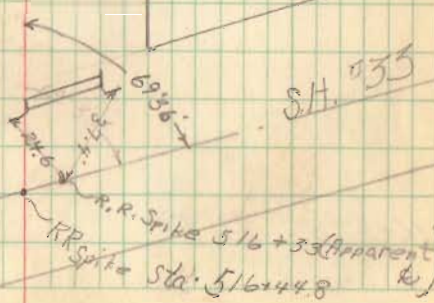

FB 685

Rd 92
Bridge 92-0.50

29+67.5

27+00 RR spike

25+00 R.R. Spike


16+32.5 HUD

57

Jason L.
Dudgen

X 1632.5 to E X

1632.5 to R

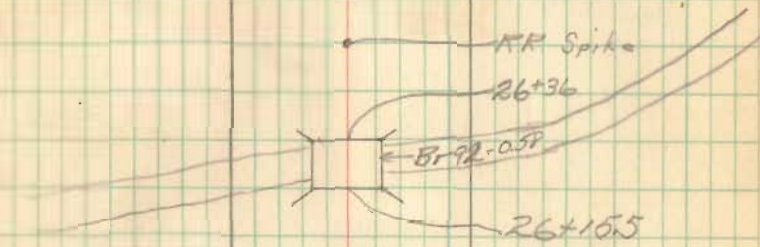

RR Spike

26+36

51-92-0.50

26+10.5

R.R. Spike

22+93 Lane ft

S 88° 30' E (Mag)

Karl E. Kent

Edna Kent

X 1635 to E X

Hubert Sta 16+32.5
Hallen Taylor

X 1635 to R

FB 685

Rd. 92

Hickory

House

8

