



REV'D 3-17-06 SMJ

CURVE	DELTA ANGLE	RADIUS	ARC LENGTH	TANGENT	CHORD LENGTH	CHORD BEARING
C1	16°03'15"	168.32'	47.16'	23.74'	47.01'	S 44°02'21" W
C2	21°31'02"	168.32'	63.21'	31.98'	62.84'	S 25°15'13" W

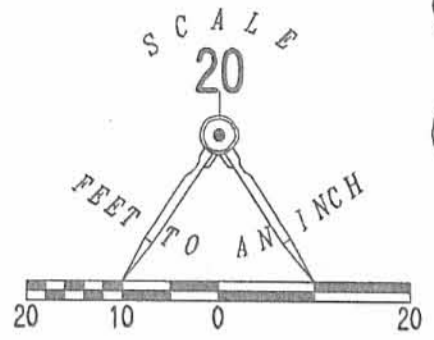

LEGEND

- 5/8 INCH IRON ROD SET
- 5/8 INCH IRON ROD FOUND
- ⊙ 1 INCH IRON BAR FOUND
- ⊙ MAG NAIL SET

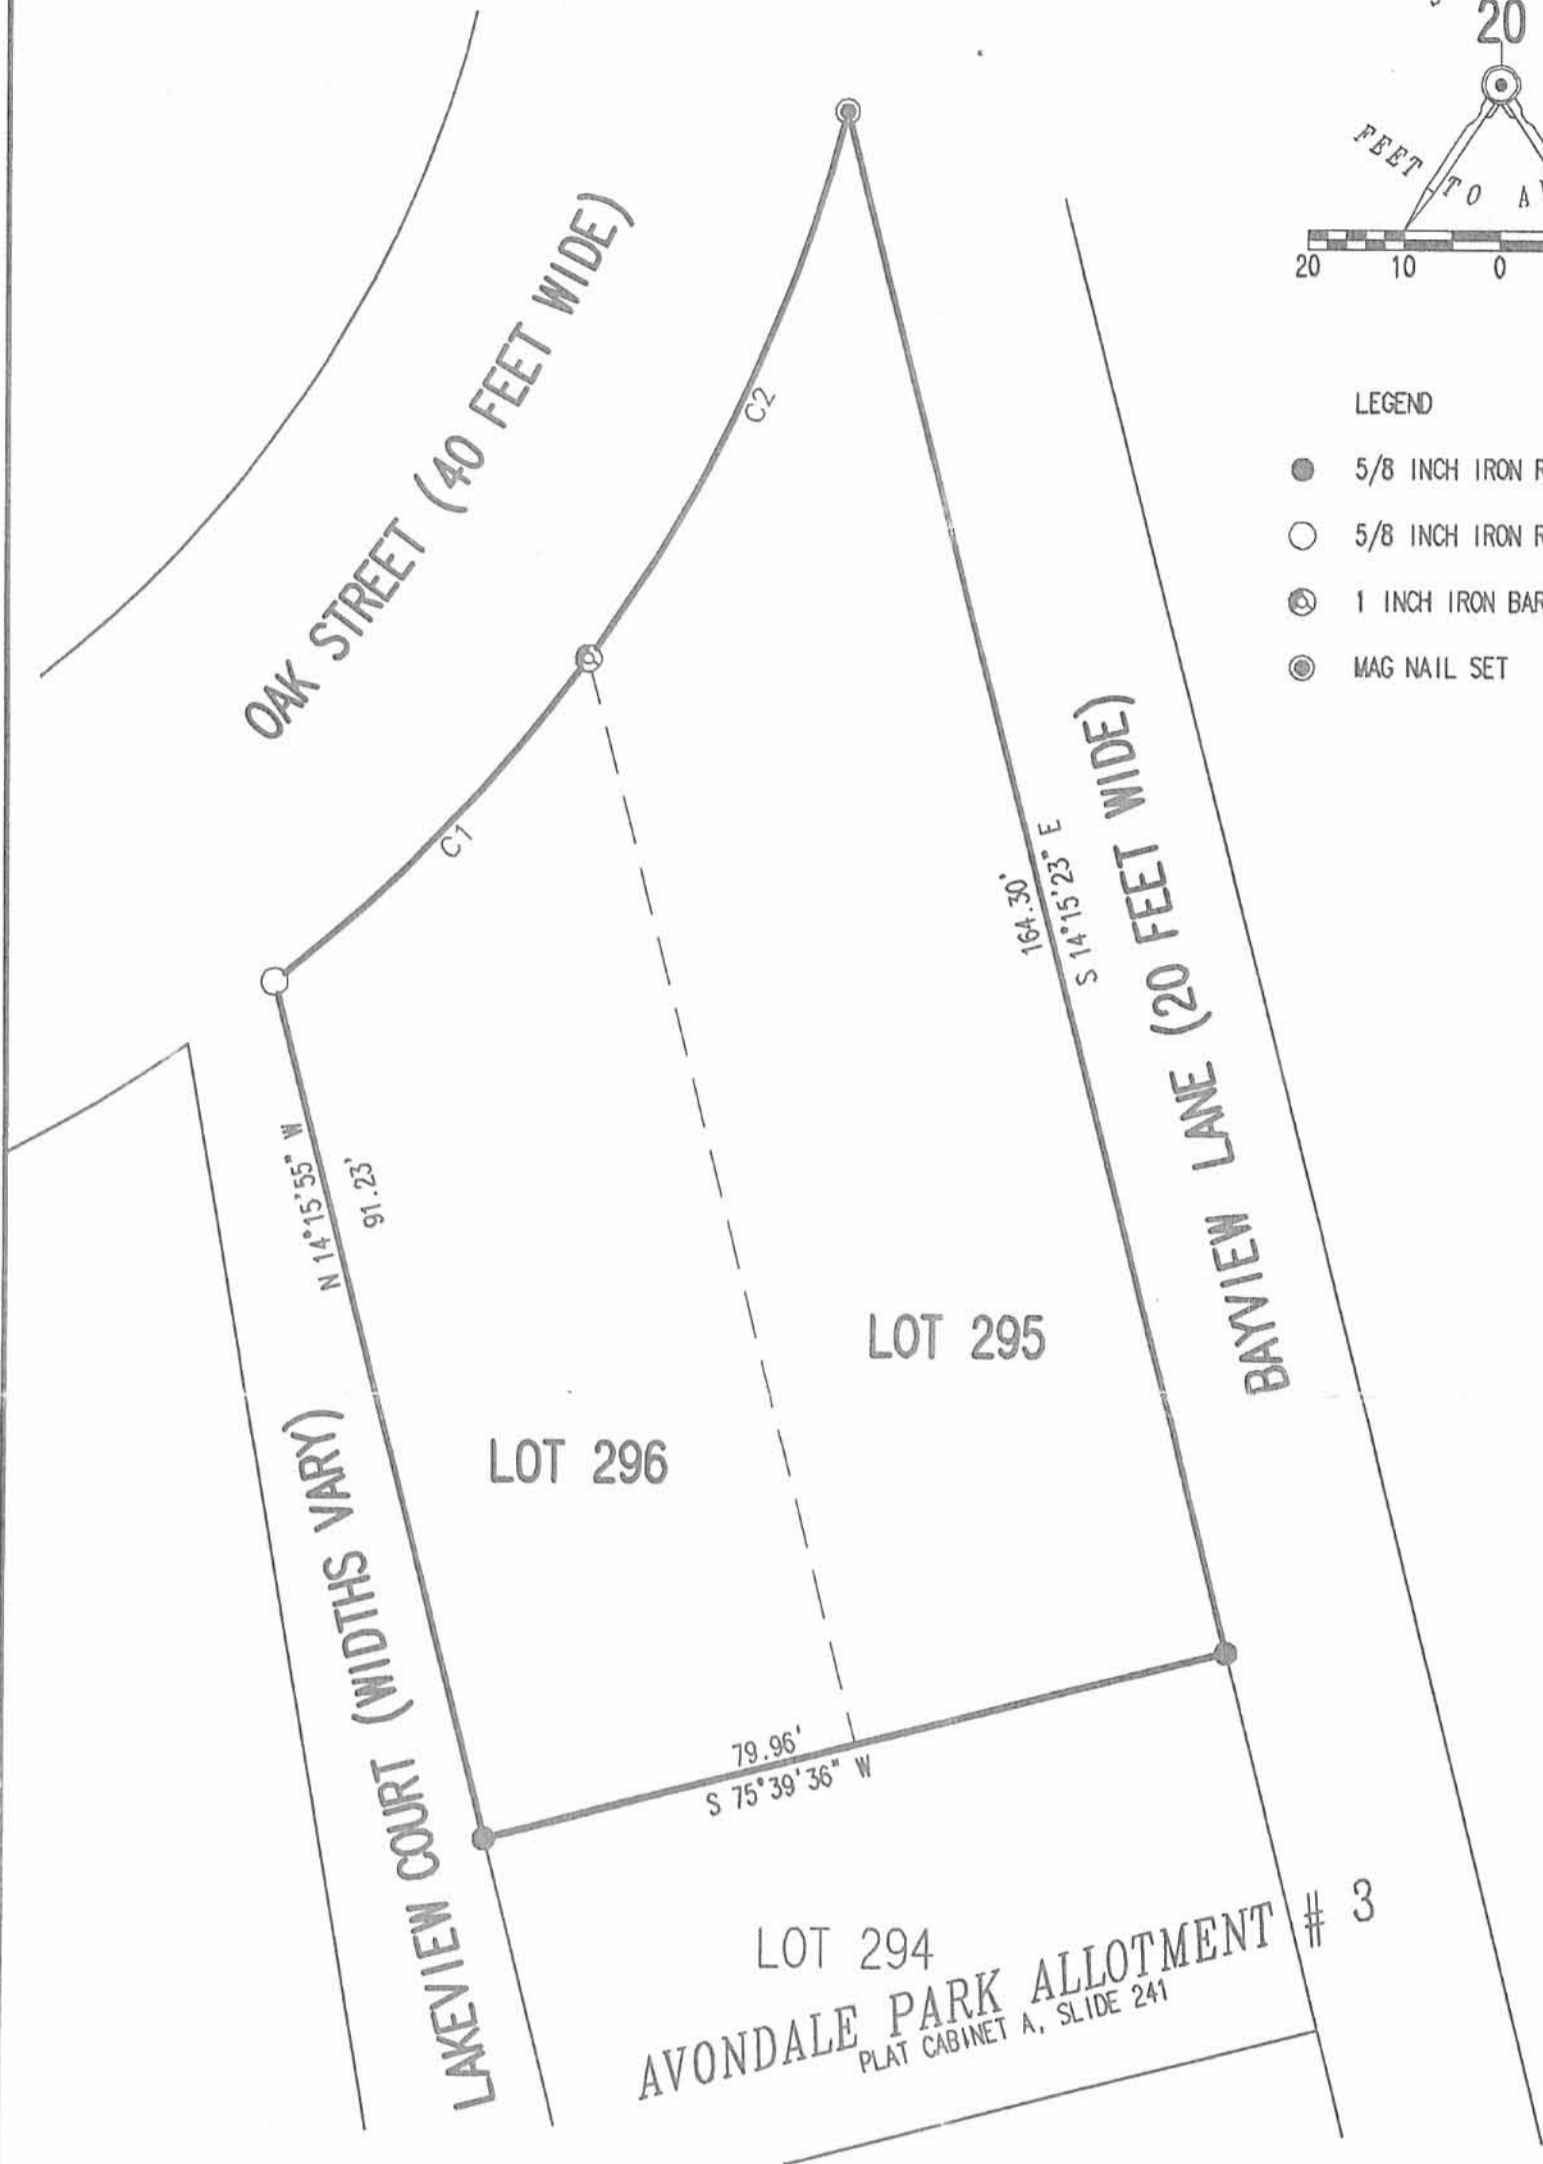

A RETRACEMENT SURVEY OF  
 LOT 296 AND LOT 295  
 AVONDALE PARK ALLOTMENT # 3  
 PLAT CABINET A, SLIDE 241  
 VIRGINIA MILITARY SURVEY 12276  
 STOKES TOWNSHIP  
 LOGAN COUNTY, OHIO

SURVEYED BY:



JEFFREY I. LEE  
 PROFESSIONAL SURVEYOR 6359  
 MARCH 9, 2006

COPYRIGHT 2006 BY:  
 LEE SURVEYING & MAPPING CO., INC.  
 117 North Madriver Street  
 BELLEFONTAINE, OHIO 43311  
 (937) 593-7335


2 WORKING DAYS  
**BEFORE YOU DIG**  
 CALL TOLL FREE 800-362-2764  
 OHIO UTILITIES PROTECTION SERVICE.

INDEXED ON MAP  
 5925 1P

ADW D0306 4197026 L-4197026-3

BAYVIEW LANE (20')

ISLAND VIEW COURT

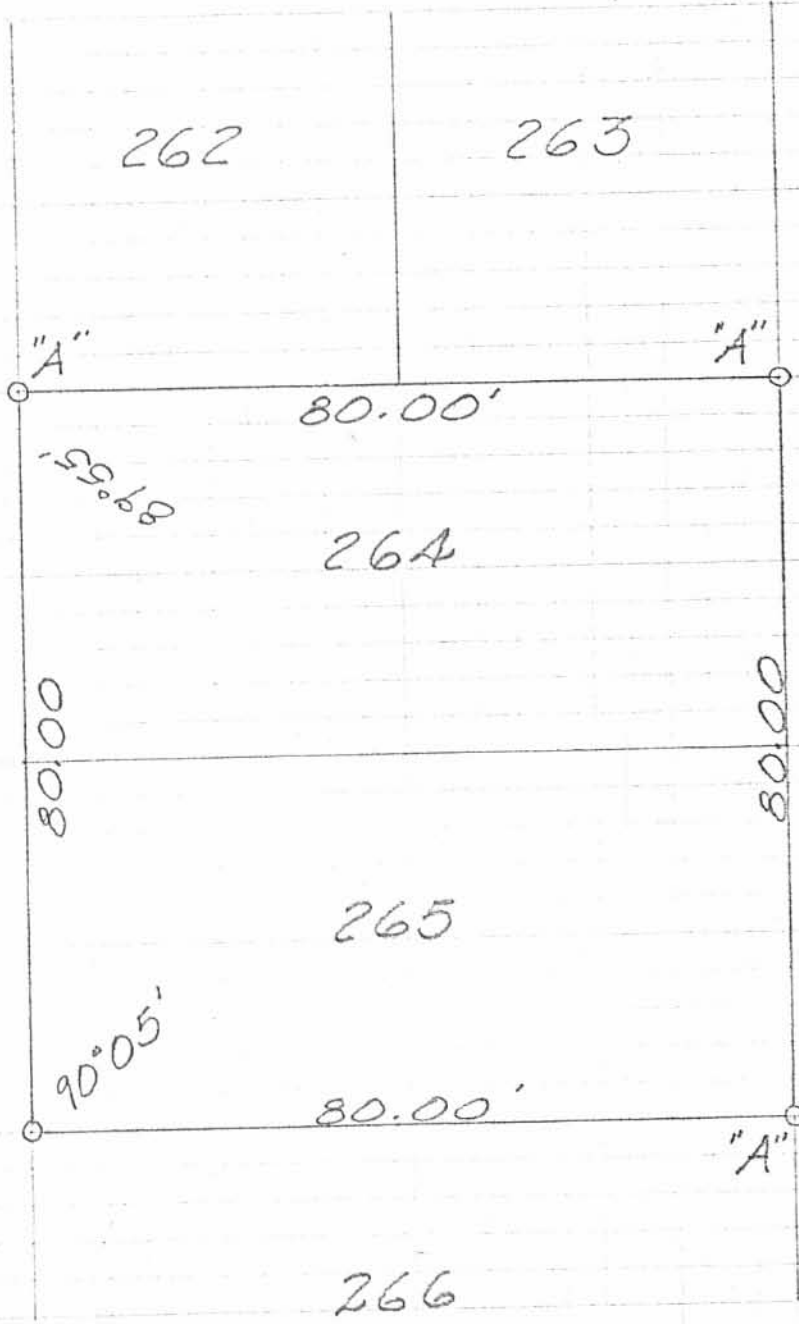

LESLIE H. GEESLIN CO.  
SURVEYORS

5925 12

5925 12

INDEXED ON MAP

SURVEY OF LOTS 264 & 265  
 AYONDALE No. 3  
 STOKES TOWNSHIP  
 LOGAN COUNTY, OHIO  
 JULY 13, 1976  
 SCALE 1" = 20'



O = 5/8" IRON BAR SET  
 A = EVIDENCE OF OLD HUB FD.  
 5/8" IRON PLACED OVER

LESLIE H. GEESLIN  
 RUSHSVLVANIA, OHIO