

4911 Tulane Rd.

July 12, 1976


DEED DESCRIPTION FOR HAROLD G. WEEKS.

Situated in the State of Ohio, County of Logan and in the Township of Stokes.

Being part of the Northeast Quarter of Section 27, Township 6, Range 8, M.R.S., and described as follows:


Beginning at the point of intersection of the westerly line of State Street with the east line of the 5.7 acre tract conveyed to Harold G. Weeks and Virginia P. Weeks by James T. Farquer by deed recorded in Deed Book 339, page 278 of the Deed Records of Logan County, Ohio, said point also being the grantor's southerly corner; thence with the line between Weeks and the grantor herein N. 0° 27' E. 272.3 feet to the northeast corner of said 5.7 acre tract; thence in an easterly direction 176.6 feet, more or less, to the westerly line of State Street; thence with the westerly line of State Street S. 33° 10' W. 326.8 feet to the place of beginning and containing 0.55 of an acre.

Harold E. Lorton
Registered Surveyor #2913

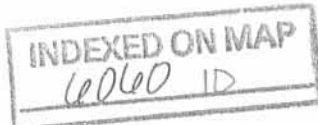

PROPERTY SURVEY
FOR
HAROLD G. WEEKS
On State Street

Being part of Section 27, Township 6, Range 8, M.R.S., and being in Stokes Township.

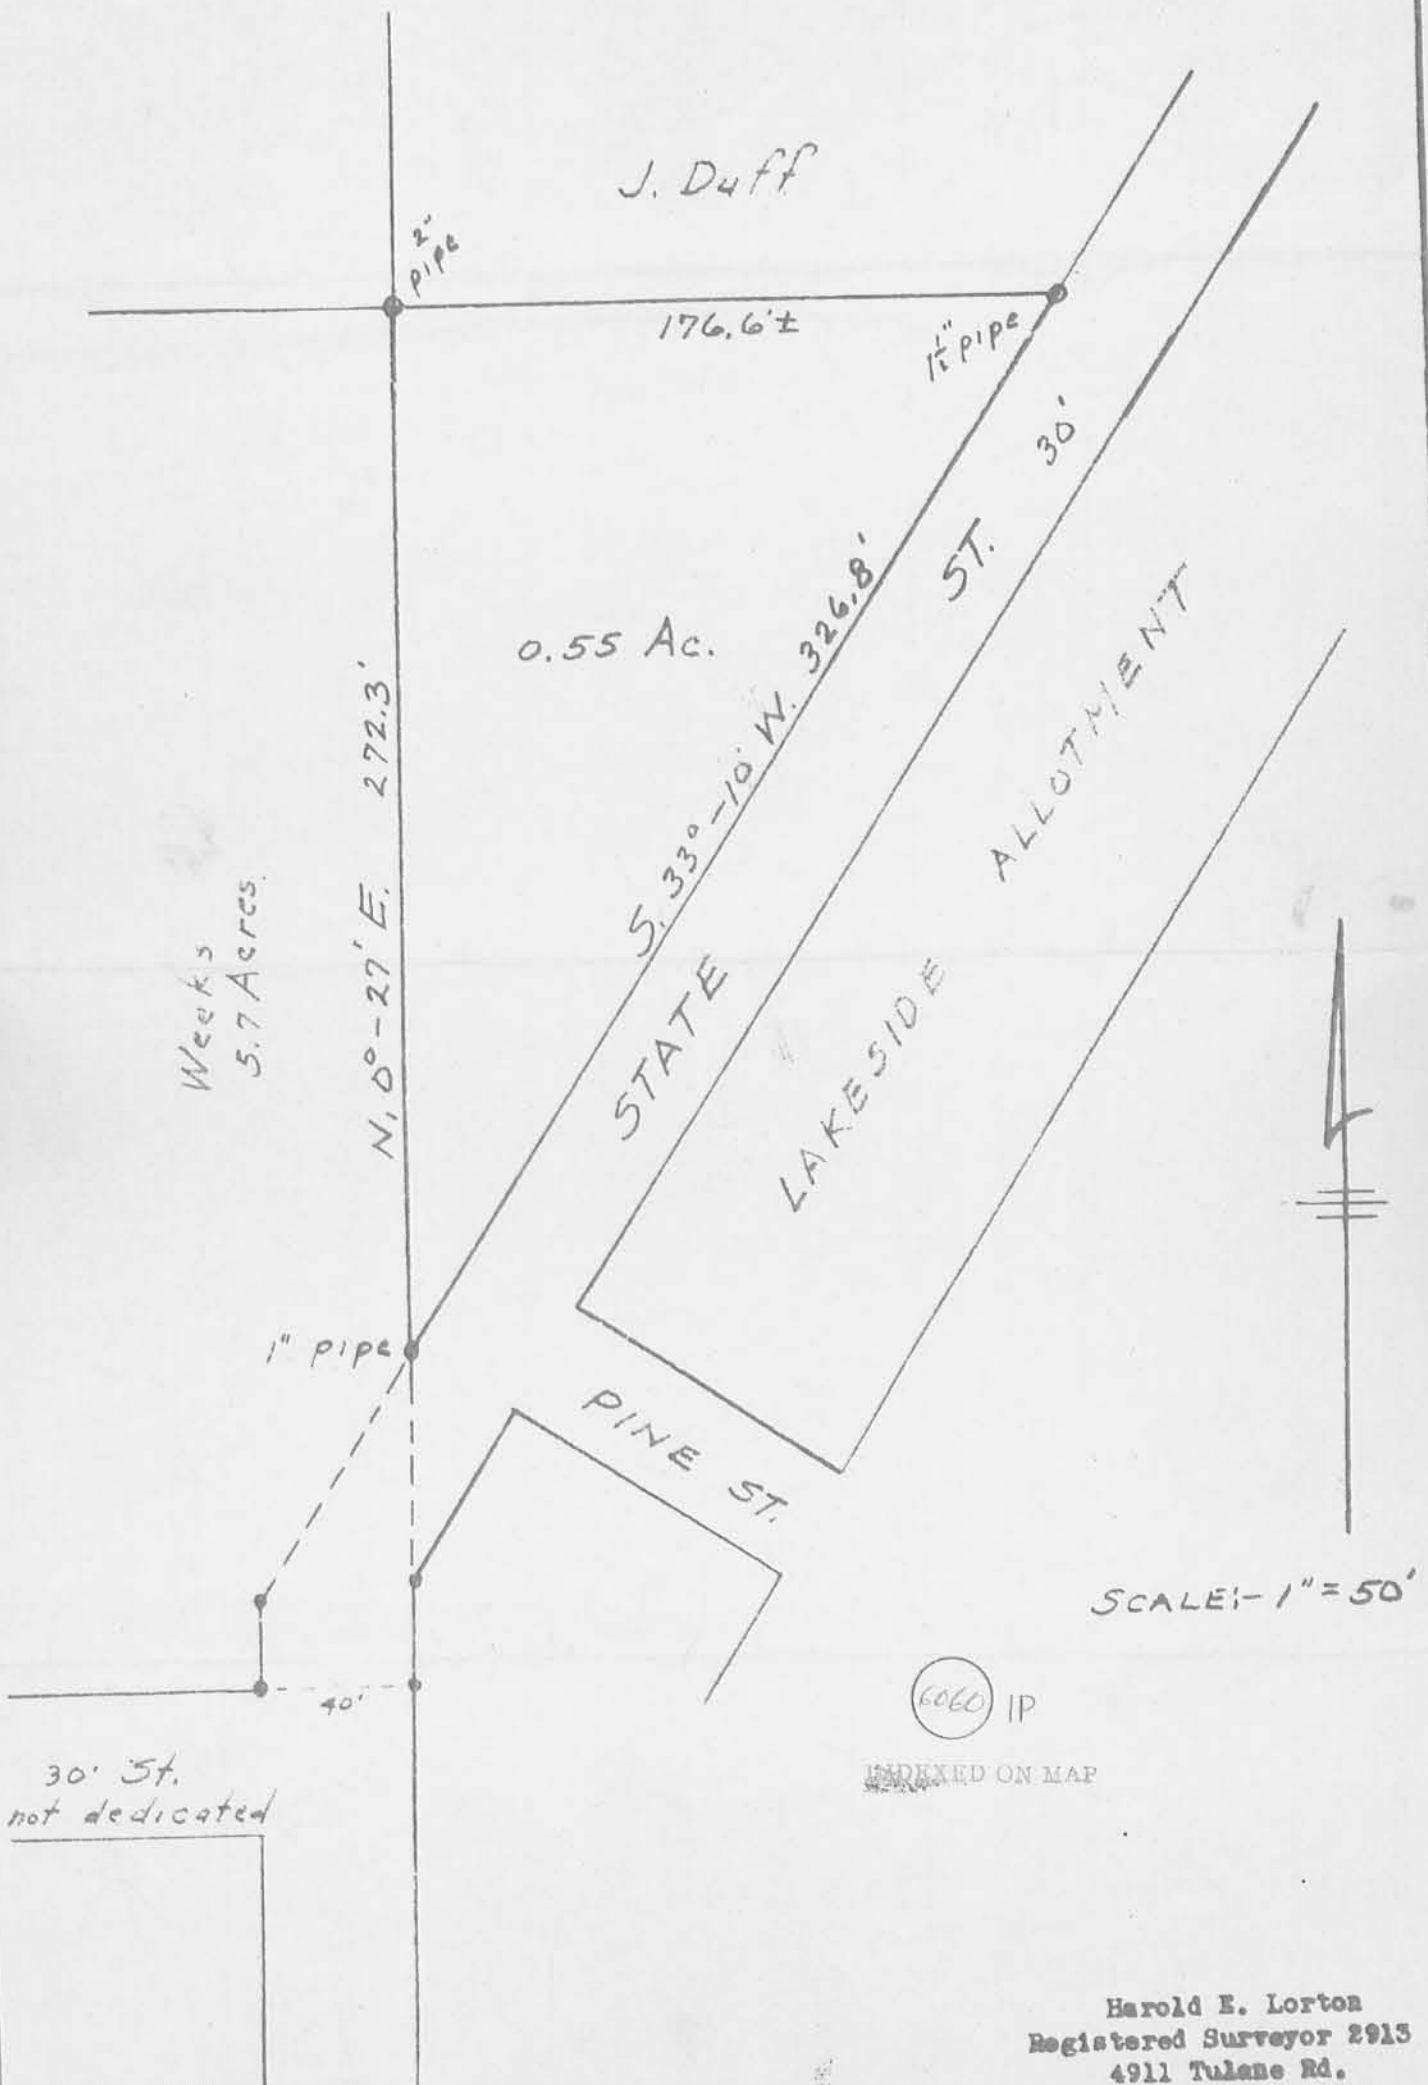

Weeks
5.7 Acres.

J. Duff

176.6'±

0.55 Ac.

S. 33°-10' W. 326.8'

ST. 30'

STATE LAKESIDE ALLOTMENT

PINE ST.

30' St.
not dedicated

July, 1976

6060 IP

INDEXED ON MAP

SCALE: 1" = 50'

Harold E. Lorton
Registered Surveyor 2913
4911 Tulane Rd.
Springfield, Ohio.