


ROBINSON SURVEY

LOTS 184, 185, & 186 NEW MIDWAY PLACE
STOKES TWP.; LOGAN CO., OHIO

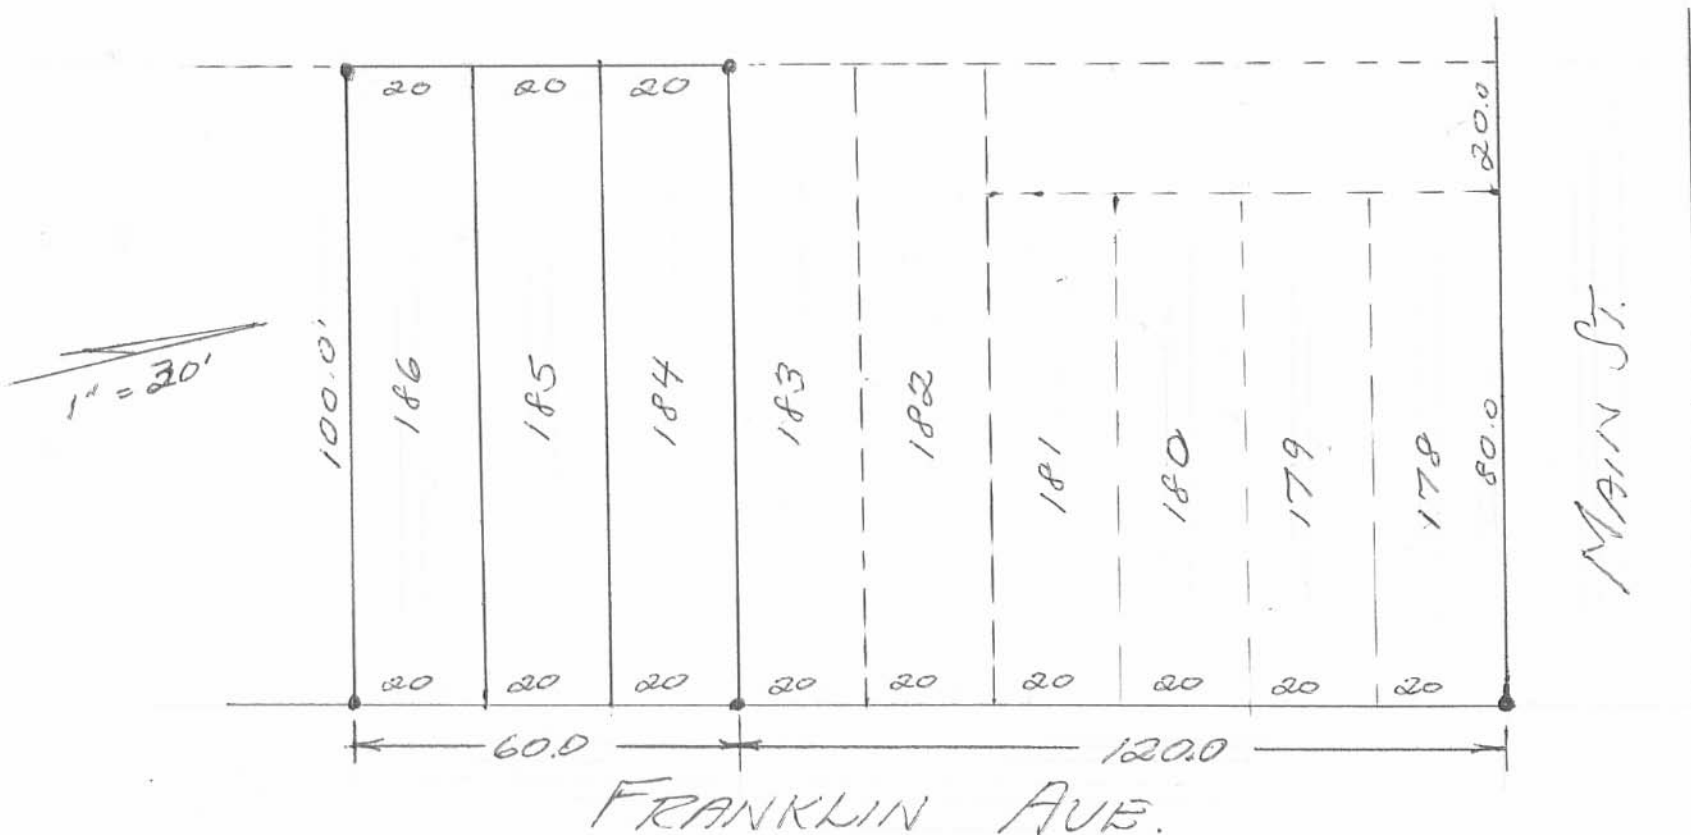

Owen K. Shirk
Surveyor 4271
Sept., 1974

(6142) 1P

INDEXED ON MAP