

William C. Aelker Survey

The following described real estate situated in the Township of Stokes, County of Logan, State of Ohio and being a part of the northwest quarter of the northeast quarter of Section 32, Town 6 South, Range 8 East and being more particularly described as follows:

Beginning at a wood corner post at the southwest corner to the northwest quarter of the northeast quarter of said Section and also being the southwest corner to William C. Aelker's present 40.00 Acre tract as described as Tract No. IV in Deed Volume 318 Page 902 (3-1-1968) of the Deed Records of Logan County, Ohio and also being the northwest corner to Allen S. Gross's present 80.00 Acre tract as described in Deed Volume 218 Page 404 (1-21-1954);

Thence with the west line of Aelker's 40.00 Acre tract, N.  $0^{\circ}03'$  W. 595.87 feet to a R. R. Spike in the centerline of S. R. No. 720, passing the center of Muchinnippi Creek at 150.00 feet, an iron pipe at 215.87 feet and an iron pipe at the west side of S. R. No. 720 at 538.04 feet;


Thence with the centerline of S. R. No. 720. S.  $31^{\circ}18'$  E. 697.00 feet to a R. R. Spike in the north line of Allen J. Gross's present 80.00 Acre tract;

Thence with Gross's north line, S.  $89^{\circ}57'$  W. 361.58 feet to the place of beginning, passing through an iron pipe at the west line of S. R. No. 720 at 35.09 feet and the center of Muchinnippi Creek at 251.58 feet, containing 2.478 Acres, more or less.

The above described tract being surveyed out of the southwest corner of William C. & Helen Aelker's present 40.00 Acre tract as being Tract IV in Deed Volume 318 Page 902 of the deed records of Logan County, Ohio.

I hereby certify that this is a true and accurate description of a survey made by me on August 12, 1978.


*Daniel E. Gilbert*  
Daniel E. Gilbert, P.S.  
Reg. Sur. No. 5402  
1041 N. Main St.  
Bellefontaine, Ohio 43311

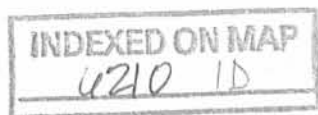



WILLIAM C. AELKER ETUX  
D. Vol. 318 P. 902

40.000 Ac.  
- 2.478 SURVEYED.  
37.522 Ac.

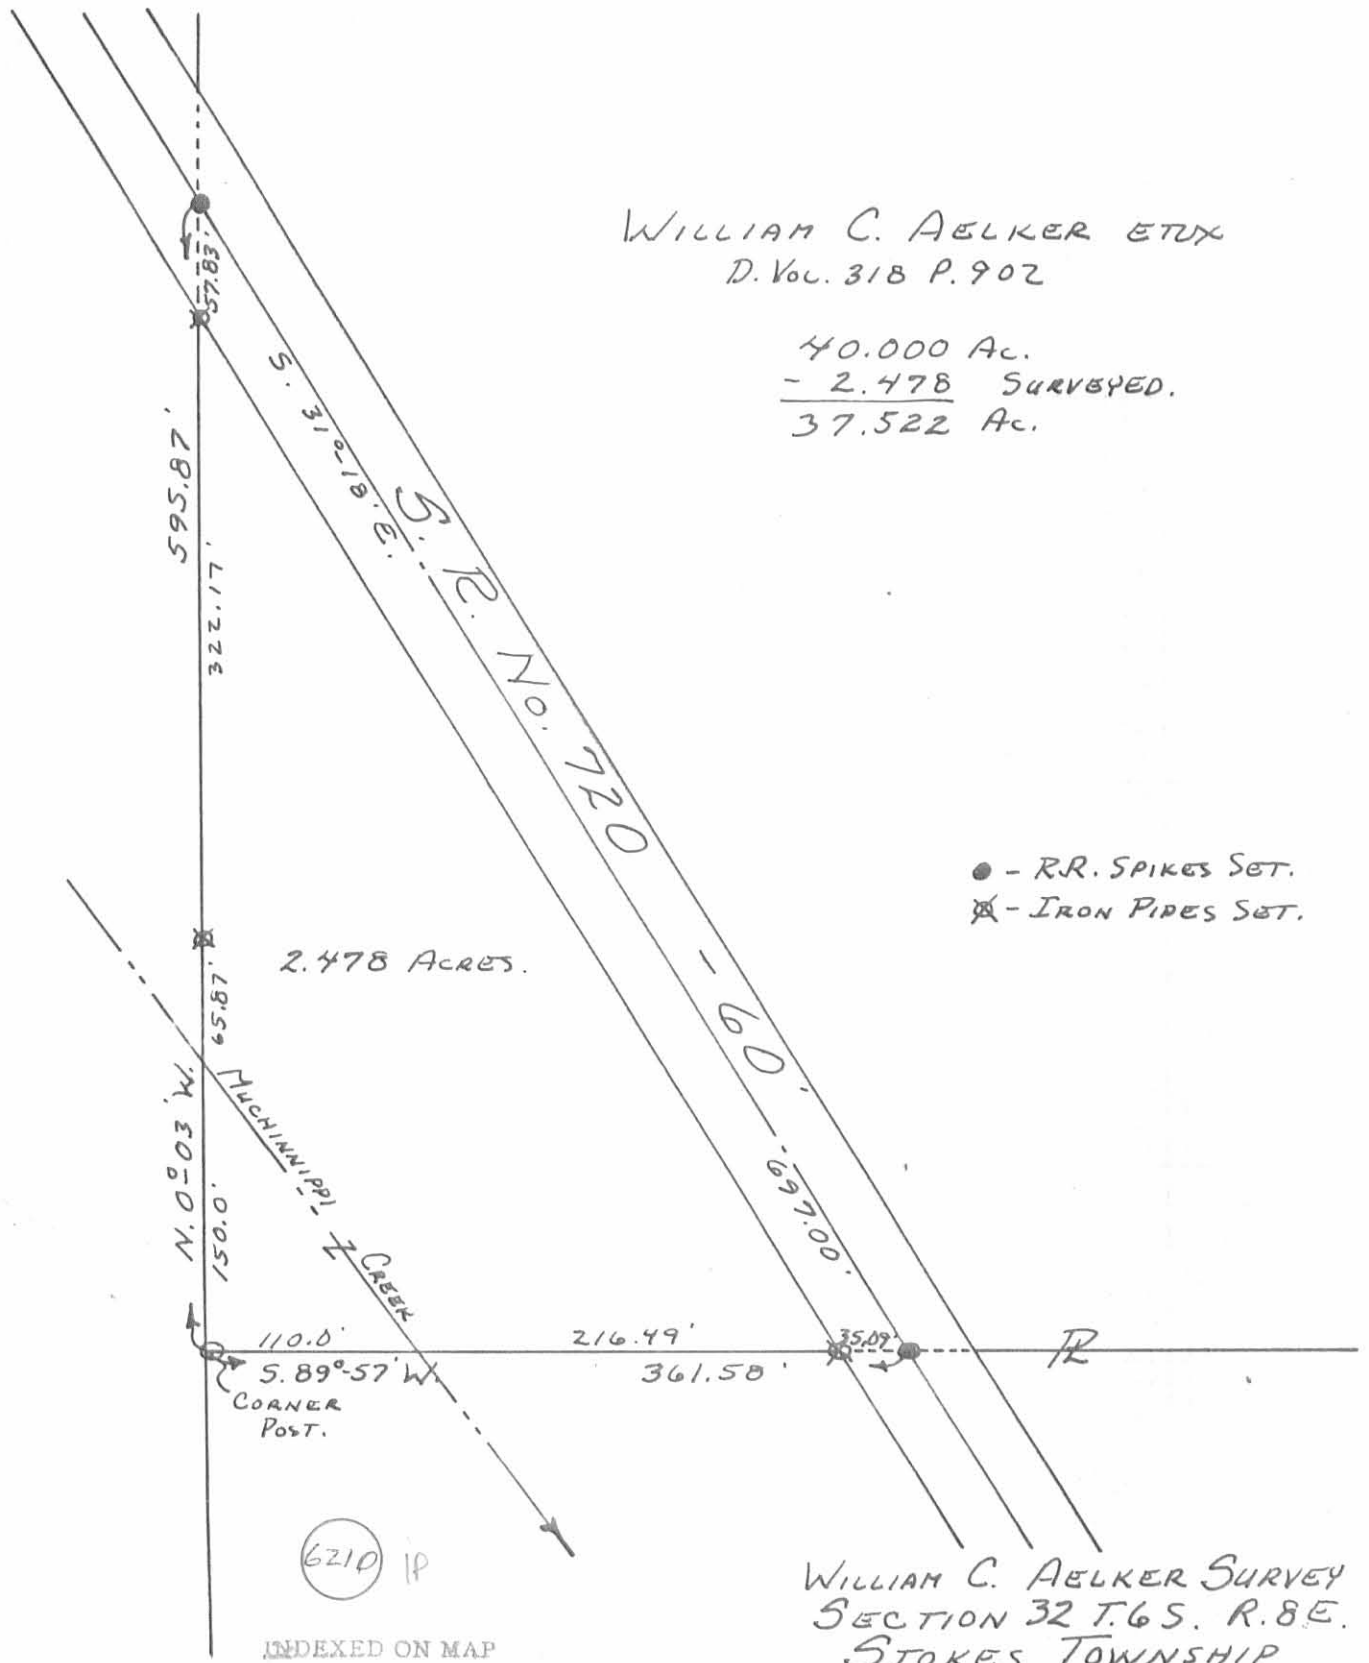

WILLIAM C. AELKER SURVEY  
SECTION 32 T. 6 S. R. 8 E.  
STOKES TOWNSHIP  
LOGAN COUNTY, OHIO  
AUGUST 12, 1978

SCALE: 1" = 100'

SURVEYED AND PLATTED BY:  
DANIEL E. GILBERT, P.S.  
REG. SUR. NO. 5402  
1041 N. MAIN ST.  
BELLEFONTAINE, OHIO 43311