

O - P.K. NAILS SET.
 O - IRON PIPES SET.

6648 1P

INDEXED ON MAP

SURVEY OF LOTS 548-637
 CHIPPEWA PARK NO. 1
 STOKES TOWNSHIP
 LOGAN COUNTY, OHIO
 JUNE 27, 1981

SCALE: 1" = 40'

SURVEYED AND PLATTED BY:
 DANIEL E. GILBERT, P.S.
 REG. SUR. NO. 5402
 1041 N. MAIN ST.
 BELLEFONTAINE, OHIO 43311

REC'D 3-11-98 SMY OLV

RAILROAD SPIKE FOUND


EAGLE PATH (35')

S 81°34'19"E
174.90'

RAILROAD SPIKE FOUND



SCALE
30

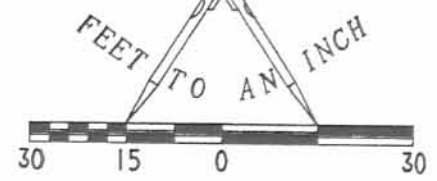

REFERENCES

LOGAN COUNTY ENGINEER'S MAP ROOM
DRAWER "R", FILE NUMBERS 5822,
6603 AND 4012.

LEE SURVEYING AND MAPPING CO.
FIELD BOOK 15, PAGE 24.

NOTES

BEARING S 08°30'16"W BASED UPON
MAGNETIC NORTH AS OBSERVED ON
DATE OF SURVEY AS SHOWN BELOW.

TECUMSEH PATH (35')

N 08°29'00"E
874.22'

839.26'

LOT 644

LOT 541

LOT 643

LOT 542

LOT 642

LOT 543
RICHARD WELLS AND RUBY WELLS
O.R. 327, PG. 808

0.112 ACRE
LOT 544

LOT 641

LOT 640

LOT 545

LOT 639

LOT 546

BIG BEAR PATH (35')

S 08°30'16"W (BASIS FOR BEARINGS)
874.60'

BLUE JACKET PATH (35')

N 81°26'49"W
174.59'

RAILROAD SPIKE FOUND

RETRACEMENT SURVEY OF THE
RICHARD WELLS AND RUBY WELLS
LOTS NUMBERED 543 AND 544
IN CHIPPEWA PARK ALLOTMENT NO. 1
OFFICIAL RECORD 327, PAGE 808
STOKES TOWNSHIP
LOGAN COUNTY, OHIO



SURVEYED BY:

Jeffrey I. Lee
JEFFREY I. LEE
PROFESSIONAL SURVEYOR 6359
MARCH 10, 1998

COPYRIGHT 1998 BY:
LEE SURVEYING & MAPPING CO., INC.
117 North Madriver Street
BELLEFONTAINE, OHIO 43311
(937) 593-7335

2 WORKING DAYS
BEFORE YOU DIG
CALL TOLL FREE **800-362-2764**
OHIO UTILITIES PROTECTION SERVICE.

INDEXED ON MAP
6648 2P

ORIGINAL STAMP IN GREEN

D 323

AGREEN

L-2627-3