

Red 10-22-01
DML OK



2 WORKING DAYS

BEFORE YOU DIG



CALL TOLL FREE **800-362-2764**


OHIO UTILITIES PROTECTION SERVICE.

LOT 121

LOT 132

WALNUT AVENUE (40')

SCALE
20

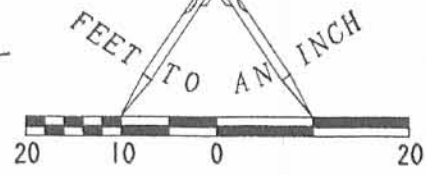

(BASIS FOR BEARINGS)
N 81° 29' 30" E

79.84'

LEGEND

- 5/8 INCH IRON ROD SET
- 3/4 INCH IRON PIPE FOUND

ASH STREET (40')

N 02° 14' 13" W
39.93'

LOT 122

39.91'
S 02° 24' 37" E

LOT 131

79.96'
S 81° 29' 17" W

LOT 130

LOT 123

LOT 129

LOT 124

LOT 128

LOT 125

RETRACEMENT SURVEY OF LOT 122
OF AVONDALE PARK ALLOTMENT NO. TWO
PLAT CABINET A. SLIDE 243
VIRGINIA MILITARY SURVEY 12276
STOKES TOWNSHIP
LOGAN COUNTY, OHIO

LOT 126

BEECH AVENUE (40')



ORIGINAL STAMP IN GREEN

SURVEYED BY:

JEFFREY I. LEE
PROFESSIONAL SURVEYOR 6359
OCTOBER 9, 2001

COPYRIGHT 2001 BY:

LEE SURVEYING & MAPPING CO., INC.
117 North Madriver Street
BELLEFONTAINE, OHIO 43111
(937) 593-7335

D 405 SHBLANK

L-3254-3

INDEXED ON MAP
20 25 10