


SYMBOLS:  
 □ - 5/8" # Iron Bars Fd.  
 ● - 5/8" x 30" Rebars Set.

Reference:  
 New Midway Place - Slide 183.

INDEXED ON MAP  
 8674 IP

**Catterson Survey**  
 Lots 170, 171, 172, 173, 176 & 177  
 New Midway Place  
 Stokes Township  
 Logan County, Ohio

March 9, 1992

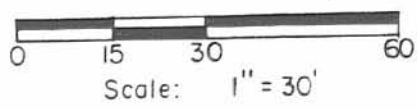

*Daniel E. Gilbert*  
 DANIEL E. GILBERT, P.S.  
 REG. SUR. NO. 5402  
 400 N. PARK ST.  
 BELLEFONTAINE, OHIO 43311  
 TELEPHONE: 1 (513) 593-1428

