


Received 6-14-94 sury @10

# MAP ROOM

## BLUE JACKET PATH - 35'

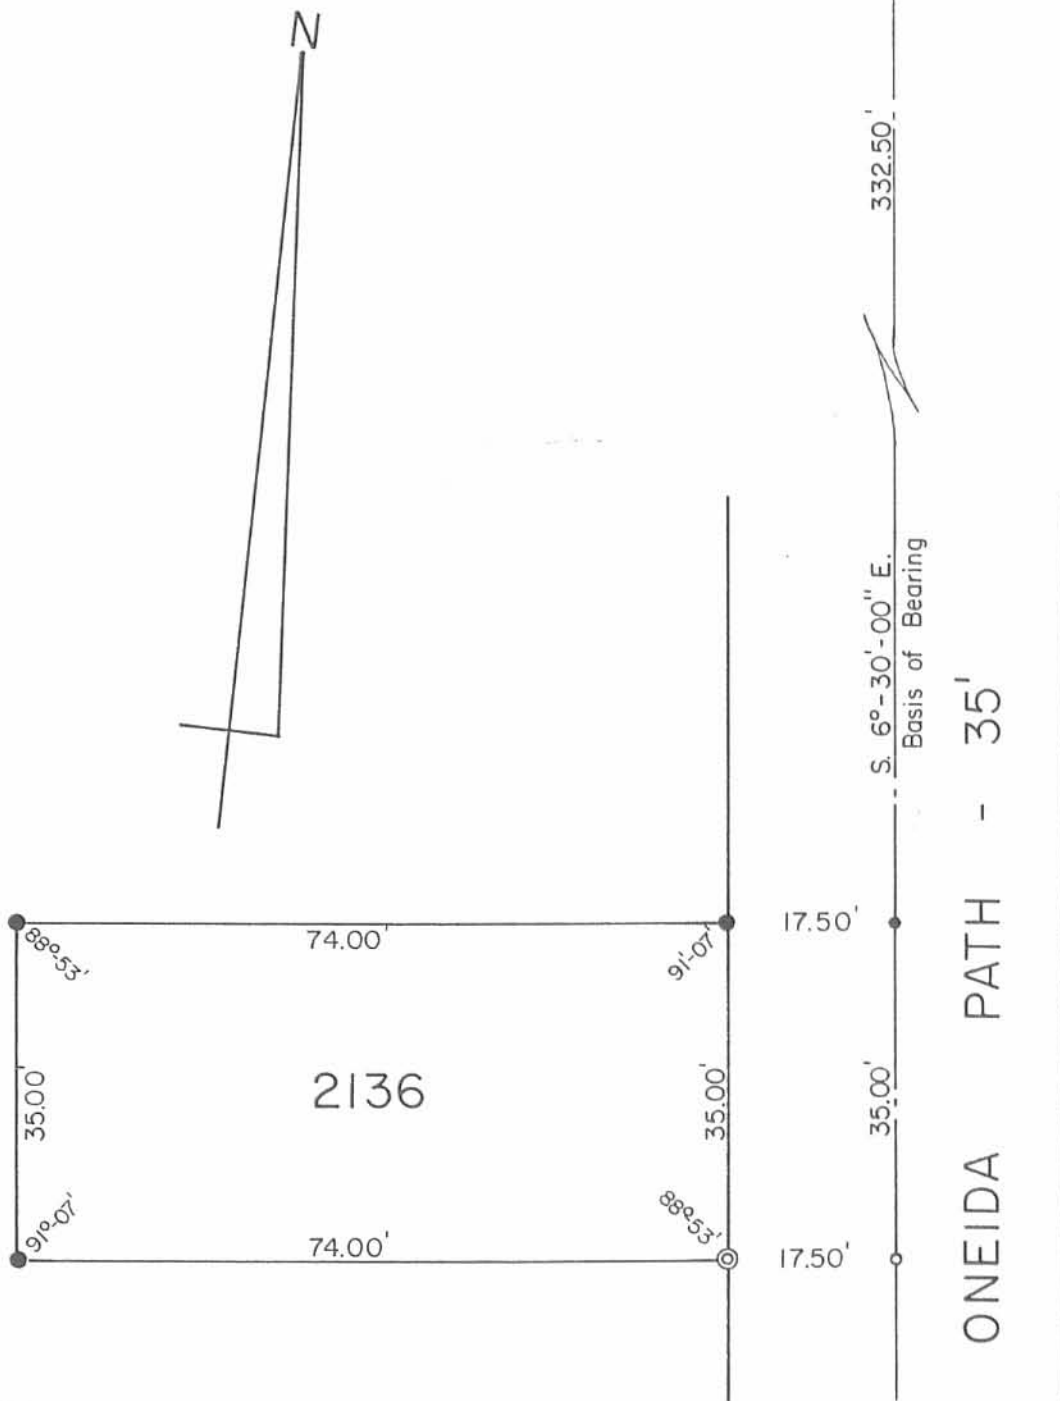

### SYMBOLS:

- - P. K. Nails Fd.
- - P. K. Nail Set.
- - 5/8" x 30" Rebars Set.
- ⊙ - 1" Iron Pipe Fd.

*Daniel E. Gilbert*  
 DANIEL E. GILBERT, P.S.

REG. SUR. NO. 5402  
 400 N. PARK ST.  
 BELLEFONTAINE, OHIO 43311  
 TELEPHONE: (513) 593-1428



Survey of Lot No. 2136  
 Chippewa Park No. 3  
 Stokes Township  
 Logan County, Ohio  
 June 9, 1994



Scale: 1" = 20'

094-040

1P  
 INDEXED ON MAP  
 8913