

FB 709

PARK LOT
 LOT No 154 - SEMINOLE ISLAND

AUGUST 22, 1983

85° ± SUNNY

T - D. GILBERT
 C. NICHOLS
 C. DILL


REFERENCE:

RESURVEY LOTS 151 TO 158
 SEMINOLE ISLAND
 SUBDIVISION A (JULY 1945)
 LO. CO. ENG. FILE J-65

8-22-1983

85°

15

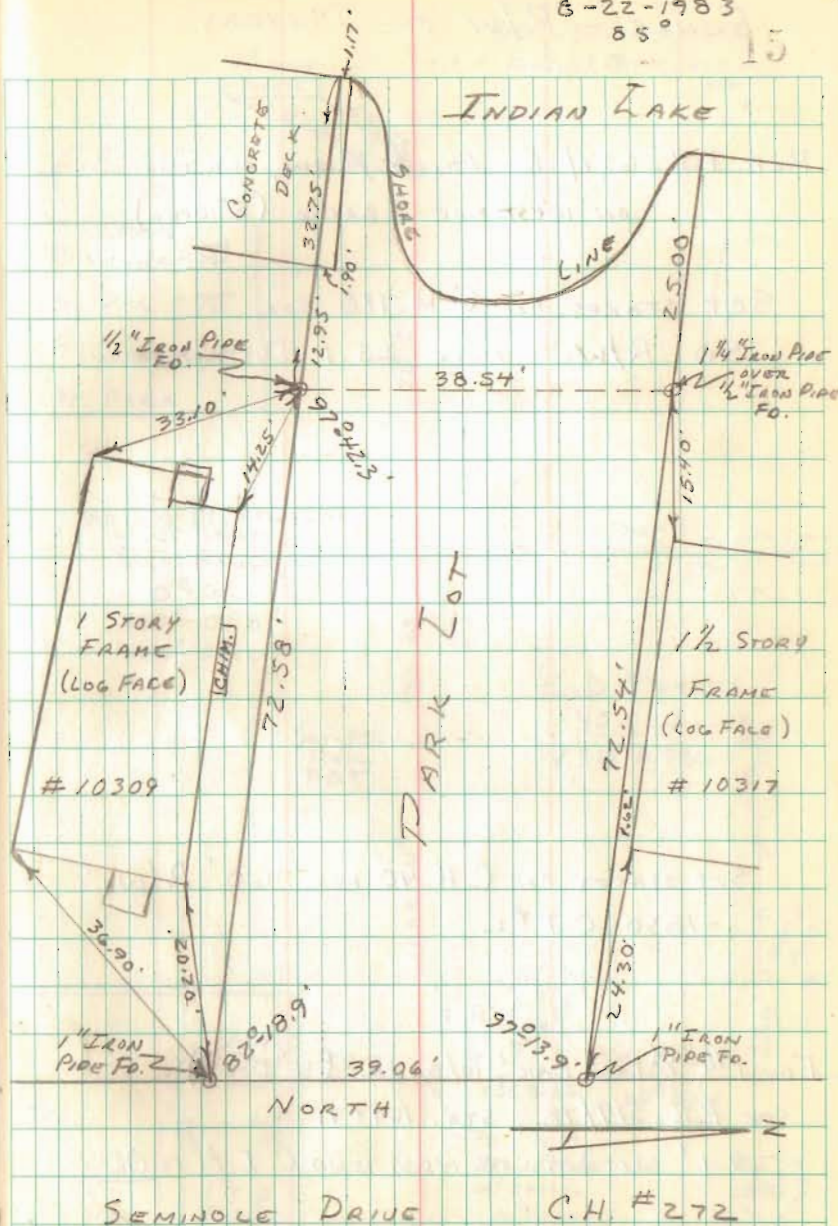

6960