


SCALE: 1" = 50'

LEGEND:

- = P.K. NAIL FD
- △ = RIRSPK. FD
- = 5/8" IRON BAR SET
- ☉ = 36" MAPLE TREE

SURVEY OF LOTS
 1526 AND 1527 IN
 CHIPPEWA PARK,
 STOKES TWP., LOGAN CO.,
 OHIO, OCTOBER 1, 1997
 FOR IVES ORAHOOD

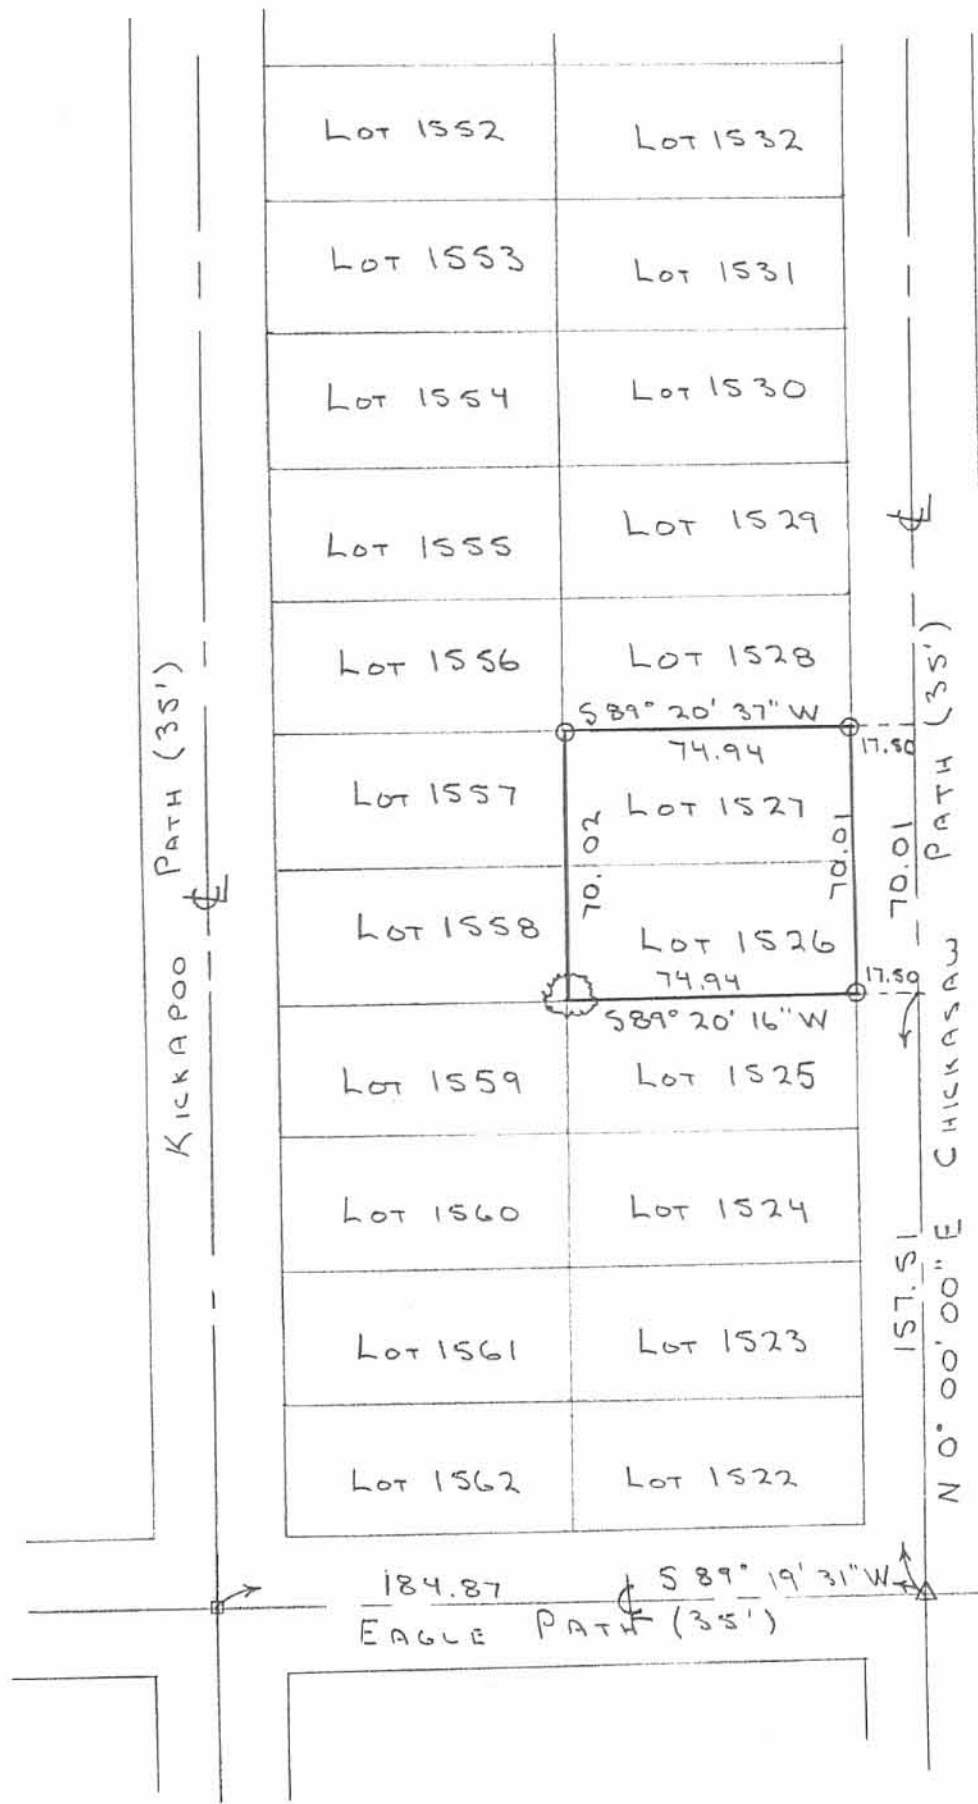

Leslie H. Geeslin
 LESLIE H. GEESLIN
 RUSHSVLVANIA, OHIO
 PH: (937) 468-2793

INDEXED ON MAP
 9/63 1P

(D.L.G)