


REC'D 8-6-98 SWY

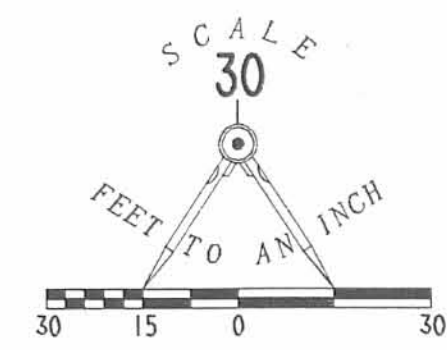

- LEGEND**
- 5/8" IRON ROD SET
  - 5/8" IRON ROD FOUND
  - ⊙ 3/4" IRON PIPE FOUND
  - ⊗ DRILL HOLE SET IN CONCRETE
  - ⊕ 7/8" IRON ROD FOUND

INDIAN LAKE

RETRACEMENT SURVEY OF THE RICHARD A. MULLEN  
 EAST HALF OF LOT 59, AND ALL OF LOTS 60 AND 70  
 OFFICIAL RECORD 29, PAGE 7  
 OF TECUMSEH ISLAND, INDIAN ISLES ALLOTMENT  
 PLAT CABINET A, SLIDE 226  
 VIRGINIA MILITARY SURVEY 12276  
 STOKES TOWNSHIP, LOGAN COUNTY, OHIO




SURVEYED BY:  
*Jeffrey J. Lee*  
 JEFFREY J. LEE  
 PROFESSIONAL SURVEYOR 6359  
 MAY 6, 1998  
 REVISED AUGUST 5, 1998

COPYRIGHT 1998 BY:  
 LEE SURVEYING & MAPPING CO., INC.  
 117 North Madriver Street  
 BELLEFONTAINE, OHIO 43311  
 (937) 593-7335

2 WORKING DAYS  
**BEFORE YOU DIG**  
 CALL TOLL FREE 800-362-2764  
 OHIO UTILITIES PROTECTION SERVICE.

INDEXED ON MAP  
 9109

APPROVED

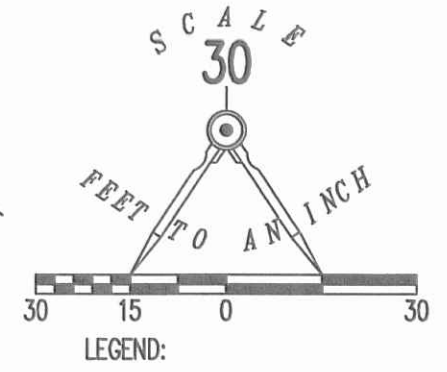

RETRACEMENT SURVEY OF THE  
 ANGELA M. SPEELMAN, SOLE TRUSTEE  
 LOT 61 AND LOT 69  
 TECUMSEH ISLAND  
 PLAT CABINET A, SLIDE 226  
 OFFICIAL RECORD 1160, PAGE 950  
 VIRGINIA MILITARY SURVEY 12276  
 STOKES TOWNSHIP  
 LOGAN COUNTY, OHIO

SURVEYED BY:

JEFFREY I. LEE  
 PROFESSIONAL SURVEYOR 6359  
 FEBRUARY 00, 2017



ORIGINAL STAMP IN GREEN

COPYRIGHT 2017 BY:  
 LEE SURVEYING & MAPPING CO., INC.  
 117 North Madriver Street  
 BELLEFONTAINE, OHIO 43311  
 (937) 593-7335  
 WWW.LSMINC.US  
 surveys@lsminc.us

KSS D0217 62160217 L-6216-3

THIS SURVEY WAS PREPARED IN THE ABSENCE OF  
 A COMPLETE AND ACCURATE TITLE SEARCH AND  
 DOES NOT GUARANTEE TITLE.



CALL TOLL FREE **800-362-2764**  
 OHIO UTILITIES PROTECTION SERVICE

INDEXED ON MAP  
 9189 5P