


REC'D 9-1-98 SMy

SCALE: 1" = 20'

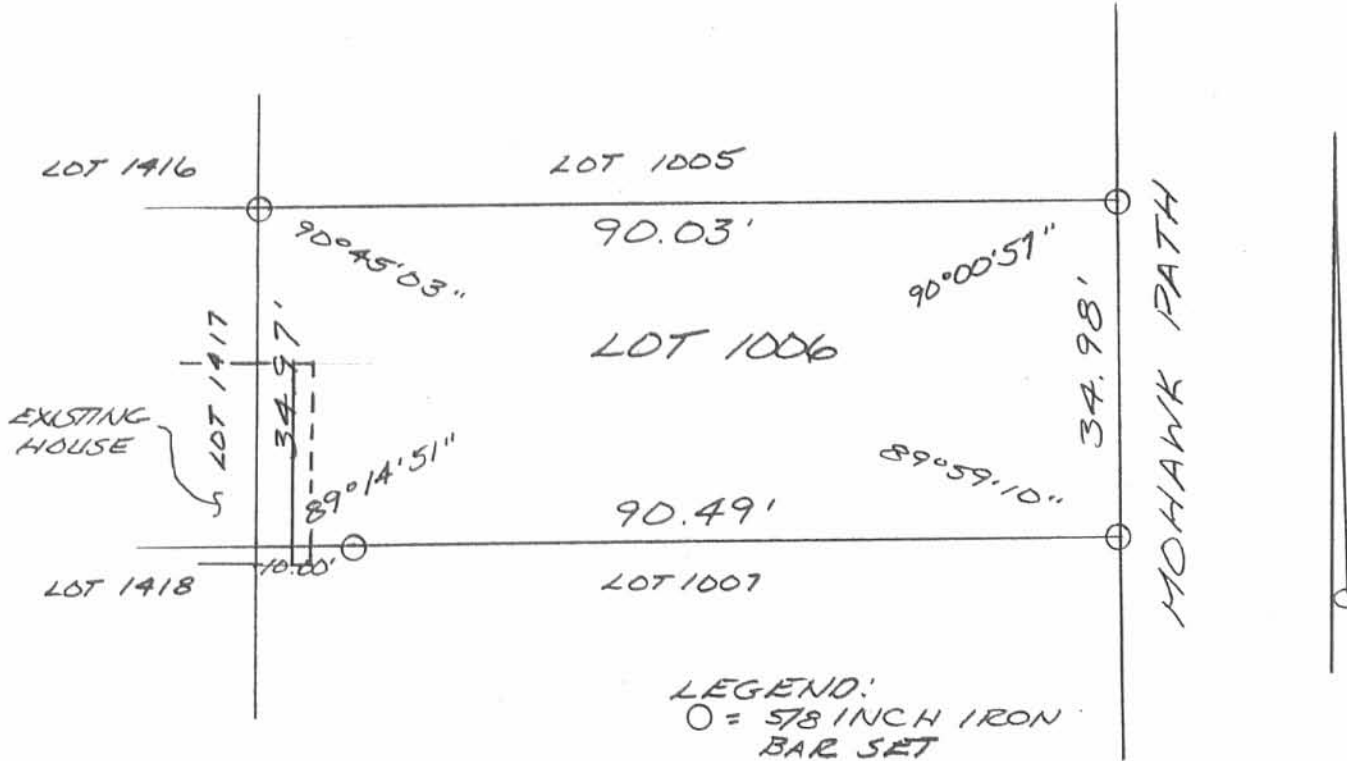

SURVEY OF LOT 1006 OF  
 CHIPPEWA PARK NO. 1 IN  
 STOKES TOWNSHIP LOGAN  
 COUNTY, OHIO FOR  
 ANTHONY TREEN ON  
 AUGUST 28, 1998



INDEXED ON MAP  
 9211

1P

Leslie H. Geeslin  
 LESLIE H. GEESLIN  
 RUSHSVLVANIA, OH  
 PH (937) 468-2795  
 FAX (937) 468-2080