


Survey of L.G. and John M. Startzman in Sec. 29 and 30 of T4 R 13 Union Tp. Logan County.

230 INDEXED ON MAP

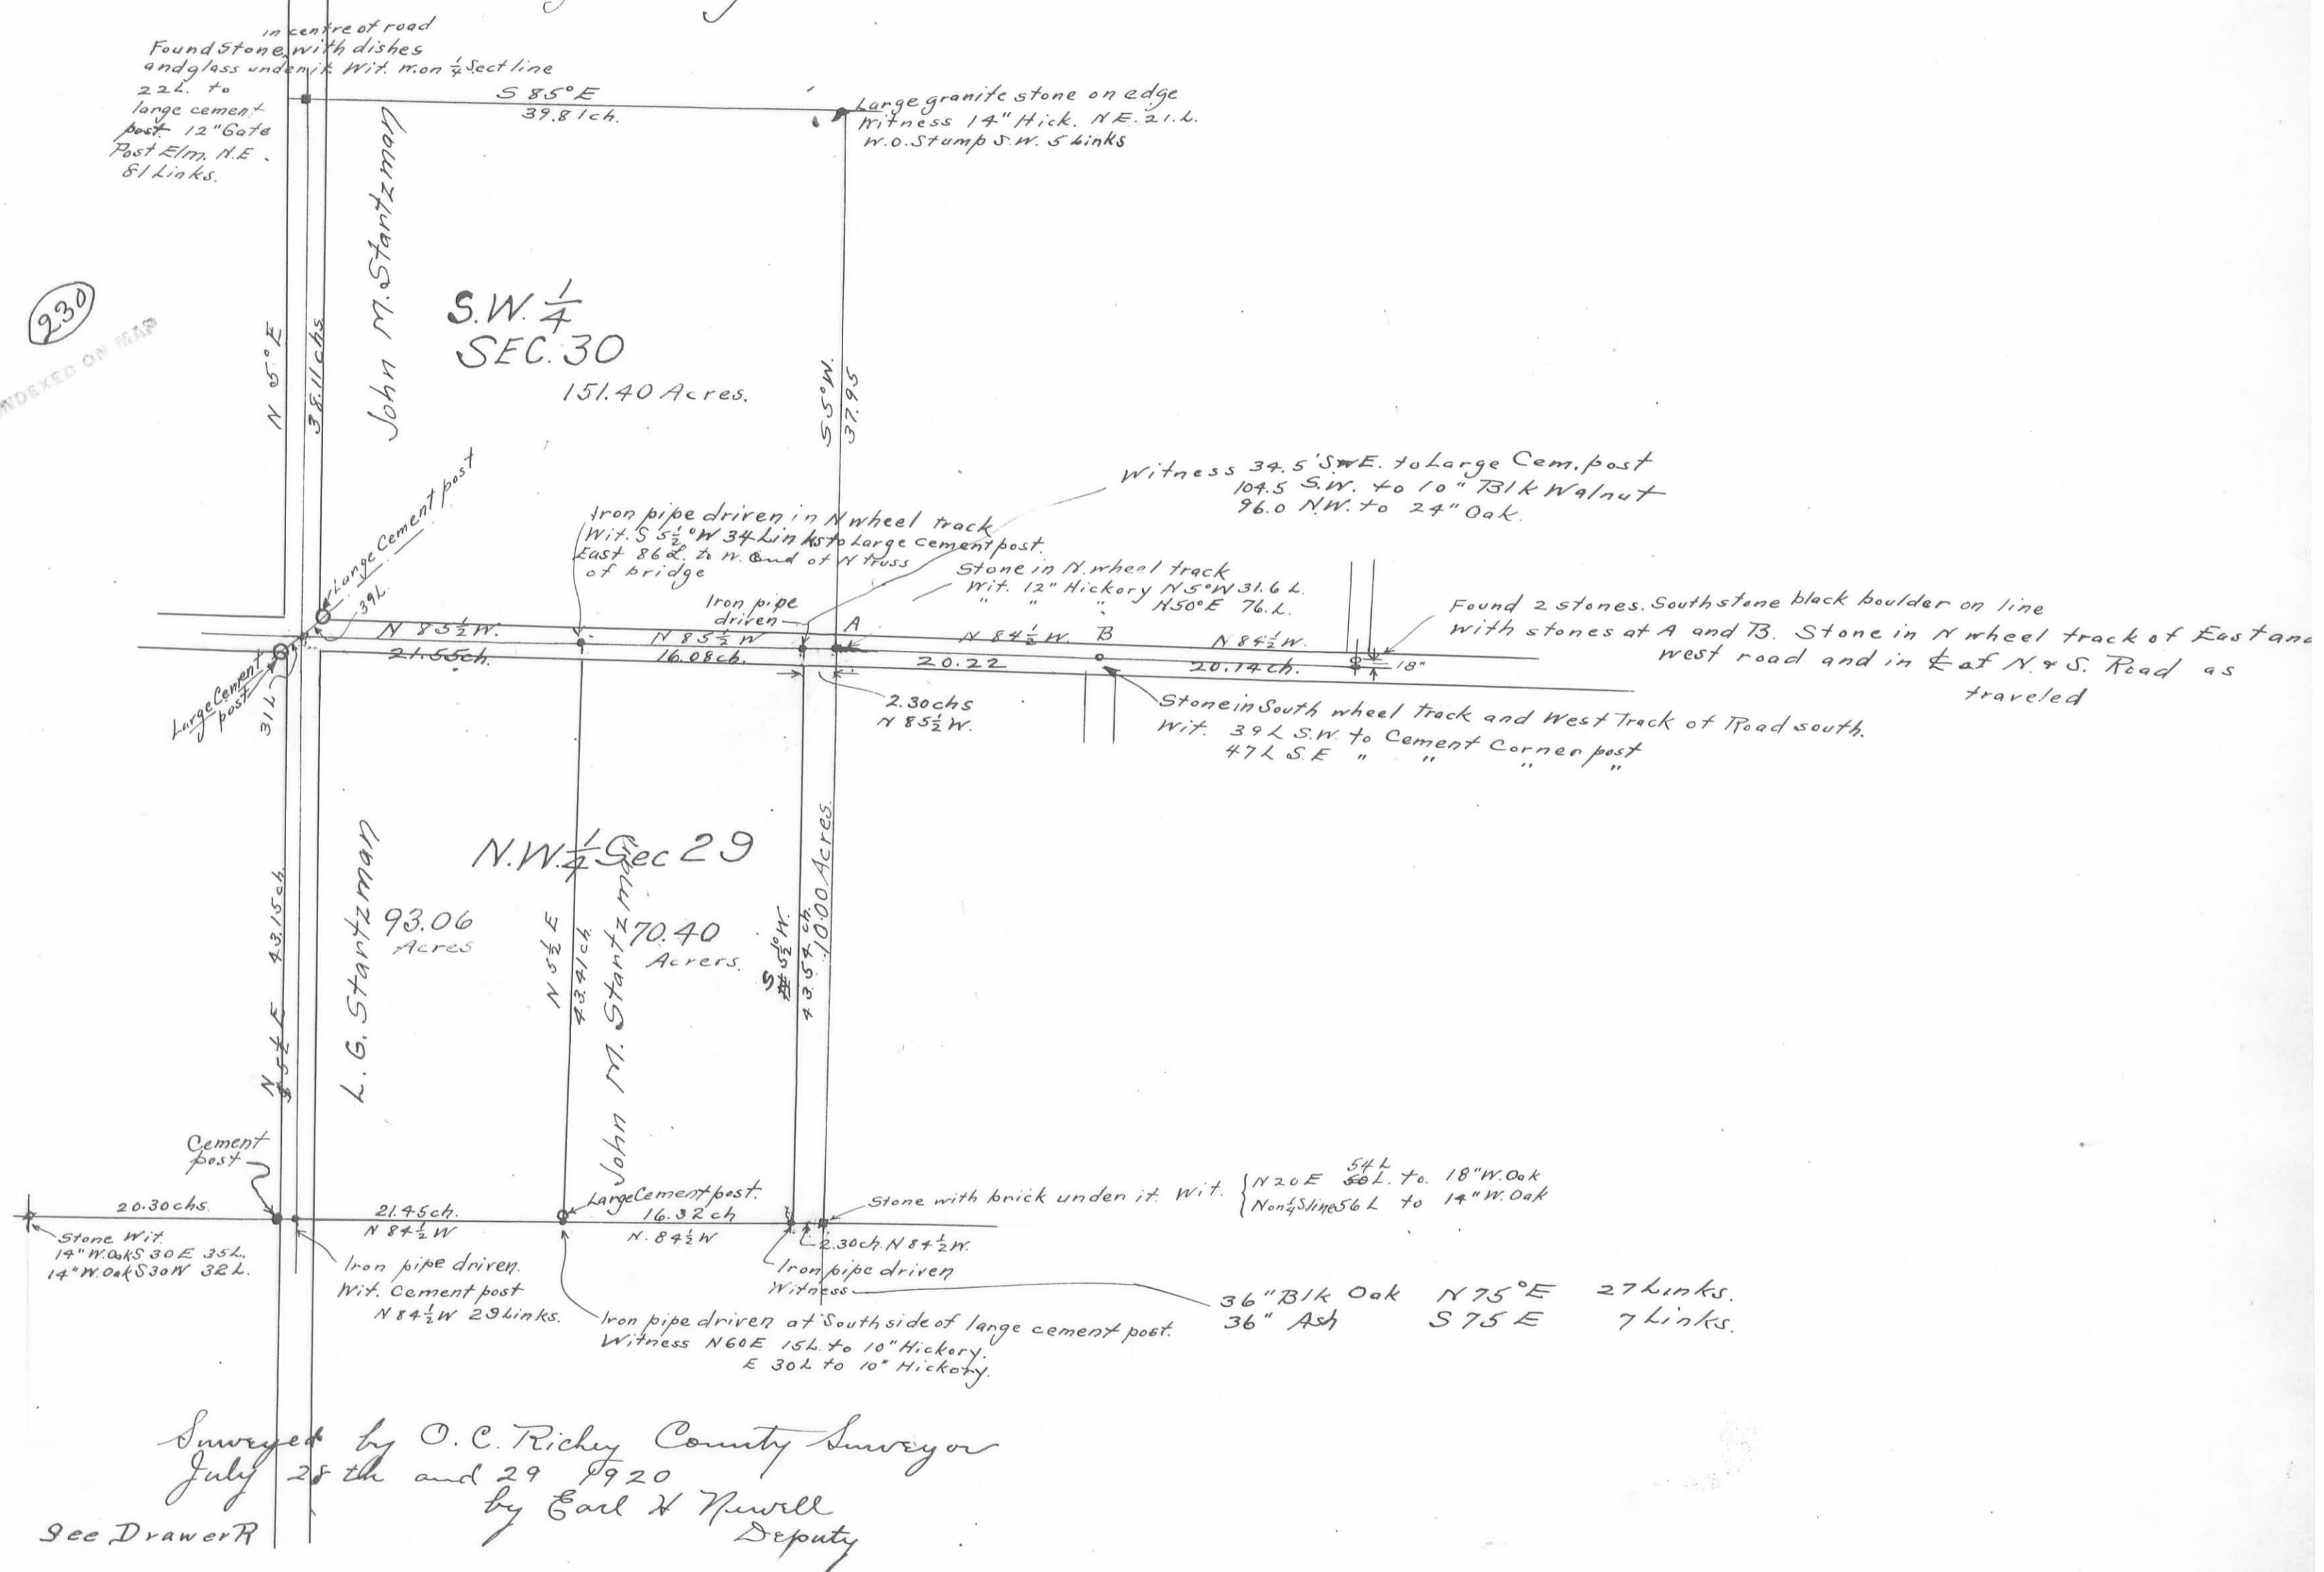

Surveyed by O.C. Richey County Surveyor July 28th and 29 1920 by Earl H Newell Deputy Sec Drawer R