


1105 17

INDEXED ON MAP

Huber survey  
Union Twp

Big Stone

Sec. 30. T. 4. R. 13. stones

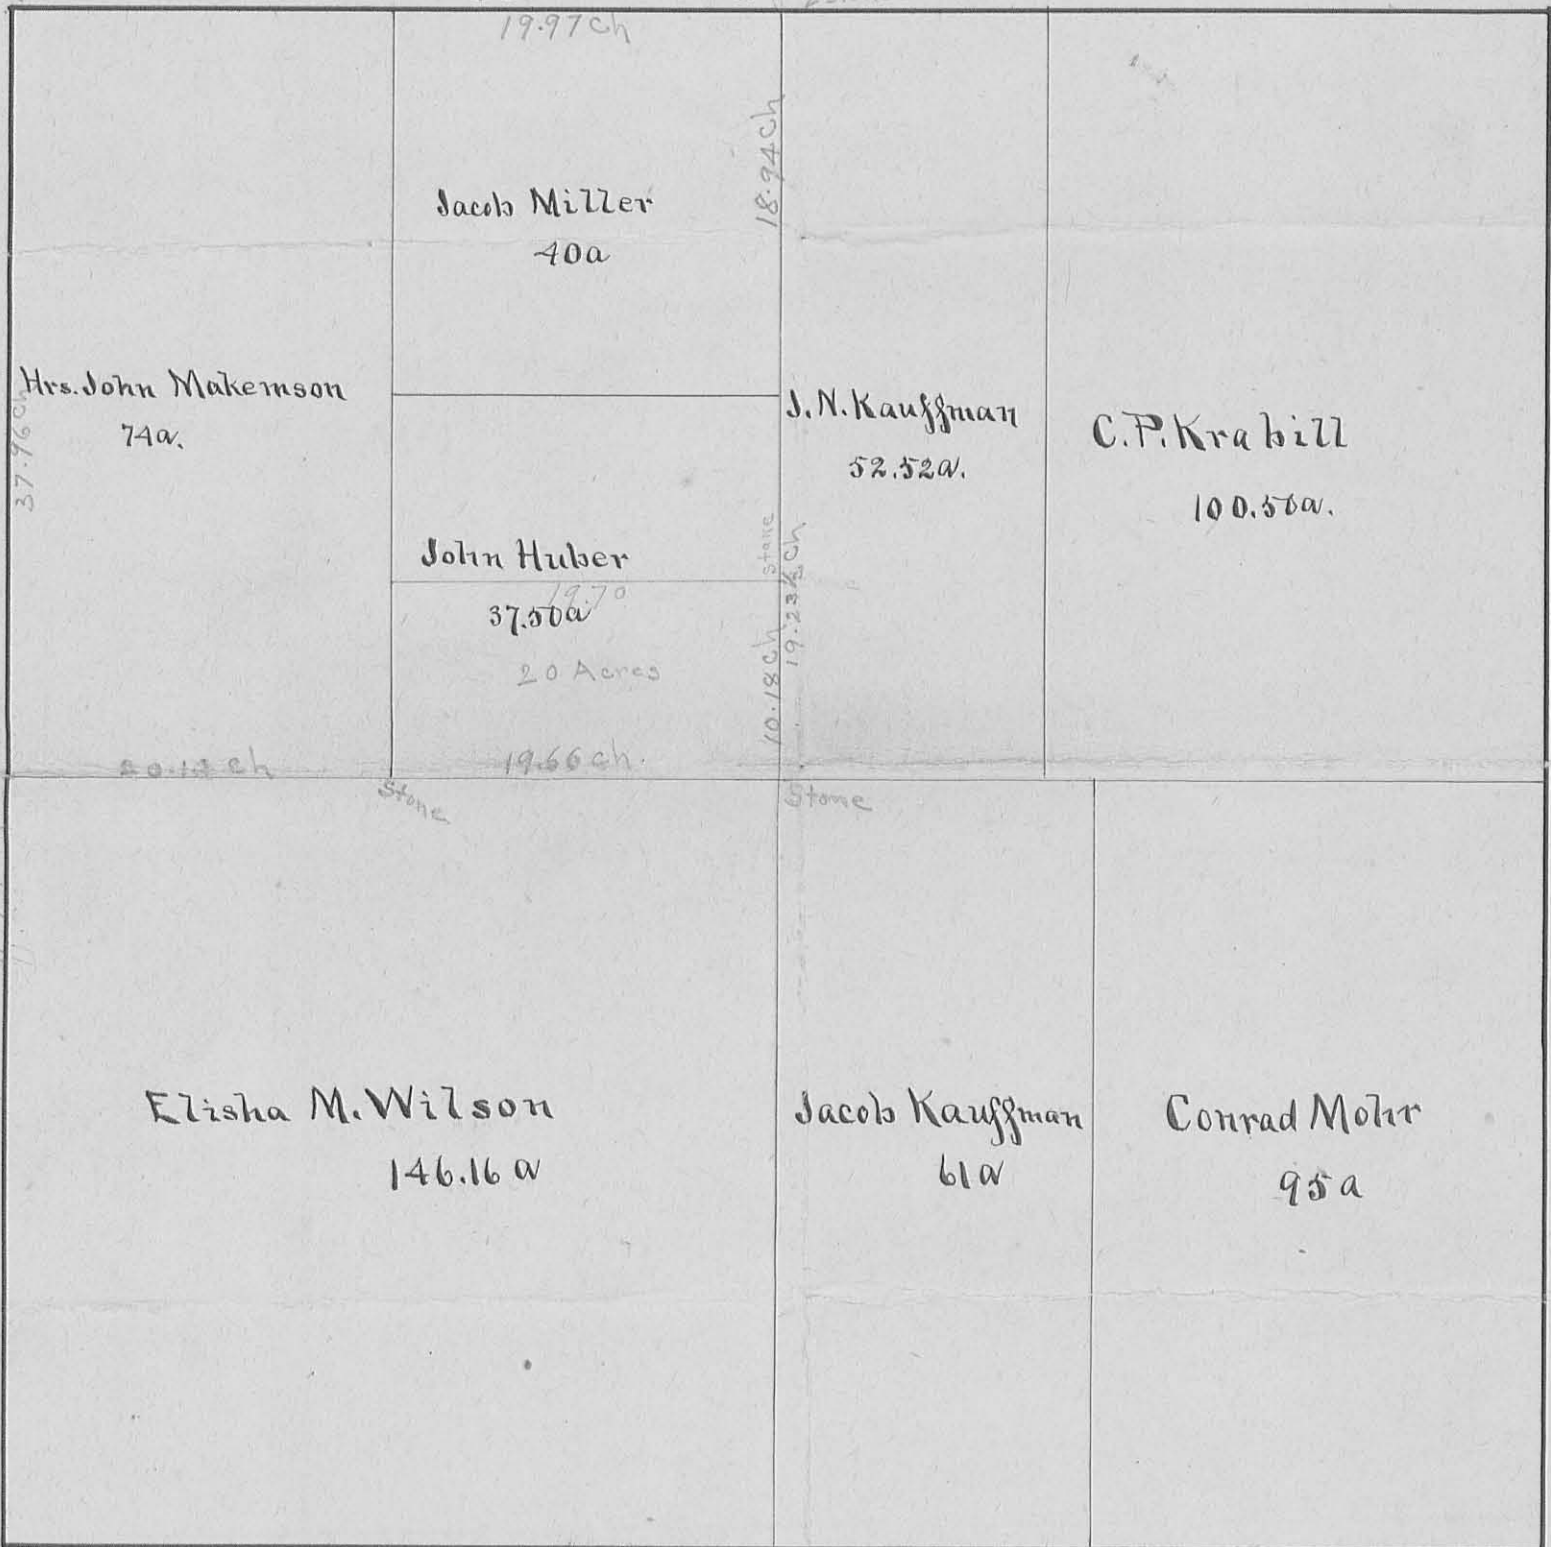

19.97 ch

Jacobs Miller  
40a

18.94 ch

Hrs. John Makemson  
74a.

37.76 ch

J. N. Kauffman  
52.52 a.

C. P. Kra bill  
100.56 a.

John Huber  
37.50 a  
20 Acres

10.18 ch  
19.23 ch  
stone

20.13 ch

19.66 ch

Stone

Stone

11.94 ch

Koogler

Elisha M. Wilson  
146.16 a

Jacobs Kauffman  
61 a

Conrad Mohr  
95 a