

Oct. 23, 1935

Plot
P. Wright
E. Cole

68

Road. 43


Union Twp.

See. Boyle C Page 25

50'
40' Road Book H Page 46
Flec Pike Record
No 1 Page 145
(There are three
places on hills
60' wide not on
this mile)
June 1870

Sec. 26
T. 3
R. 14

Road. 31
(Book 576 Page 7)

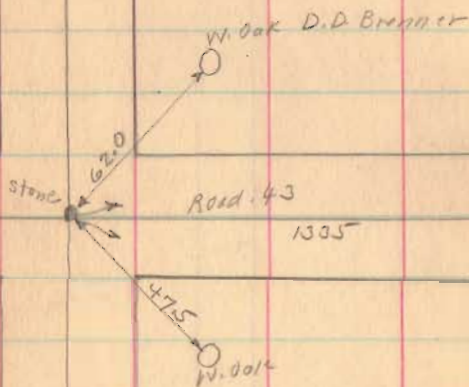

Sec. 25
T. 3
R. 14

Road. 31


W. S. Neal.

1690

INDEXED ON MAP

Sec. 20

John Brunner

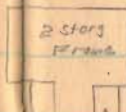

2664

1329

Sec. 19

W. S. Miranda.

Road. 46
2650
1322



T. 3 R. 14

Luther Horn

T. 3 R. 14

C.W. Pool.

(stakes placed $\frac{25'}{10}$
from E on C.W. Pool)

Road. 201

Sec. 14
T. 3
R. 14

Sec. 13
T. 3
R. 14

Two small
oak trees

