



Road No. 201 - Union Twp.

17+00 Mon. (Set)

12+00 Mon. (Set)

(1872)

INDEXED ON MAP

7/10/40


61

17+00  
Fence ← 15.0' → 18.0' → Fence

12+00  
Fence ← 15.0' → 14.2' → Fence

Hazel M. Headings

9+85  
x  
L.L. Plank

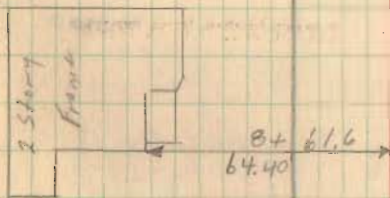



47+00 Mon. (Set)

42+00 Mon. (Set)

36+00 Mon. (Set)

31+00 Mon. (Set)

1822

INDEXED ON MAP

47+00  
19.5' 7.0'

x 44+81 x  
Drive  
x 44+65 x

42+93


Drive  
x  
42+73

42+00  
17.3' 8.0'

○

36+00  
18.5' 11.5'

Fence 31+00 Fence  
15.5' 13.6'

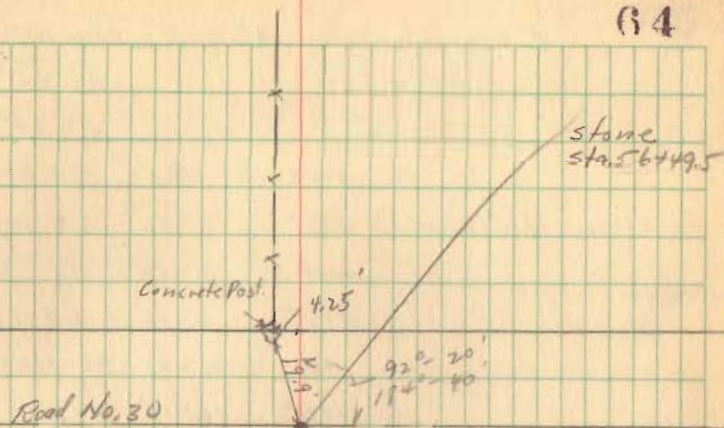

1822

INDEXED ON MAP

54+00 Mon (Set)

54+00

21.0' 9.0'

The diagram shows a horizontal line with a point labeled '54+00'. Two segments are marked below the line: one of length 21.0' extending to the left, and one of length 9.0' extending to the right.