

Survey in the N.W. and N.E
 quarters of 5. 28 T 4 R 13 and
 N.E 1/4 5. 34 T 4 R 13 Miami
 and Union Twp for Arthur Holycross
 and J. R. Harner

5-16-21

Found stone in road at N.E. corner
 39 and N.W. corner of 28. (Green stone
 set on end about 8' below surface)

Found stone in road at N.W. corner
 of N.E. 1/4 section 34. Approx 8' square
 about 6' below surface.


Measure 40.06 chs. between above stones.

Set nail near center of bridge for
 N.W. corner Holycross set 3/4" iron pipe 0.25
 chs. west of corner and 1/2" iron pipe
 east of corner both on the N. line of
 5. 34 as shown by stone at N.E. cor
 of section and stone at quarter point.

Found stone 6.75 ch west of S.E
 corner past of Holycross and a links
 south of fence between Rausenberger
 and Holycross.

C. F. Lyke
 W. E. Elliott.
 Arthur Holycross
 John Harner.

North. Exp day 24

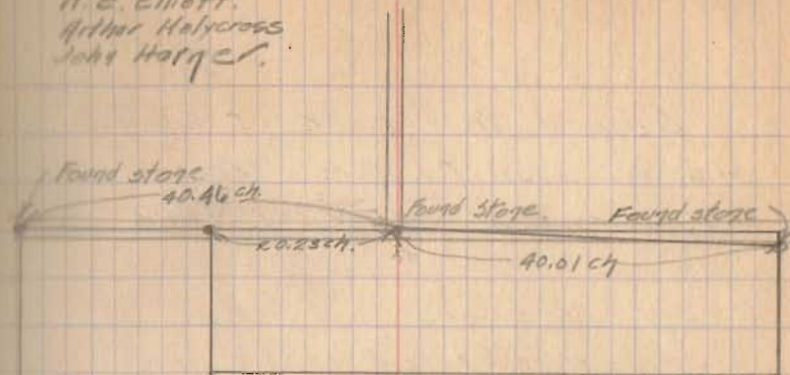

E 1/4 5. 34

W 1/4 5. 28

INDEXED ON MAP

2227

Logan Co. Measurement
 Champaign Co.

Chained from stone at N.E. cor
Halycross to I.P. in cross roads at
N.E. corner of Harner 20.29 c/lts.

Run random line from 10' west of stone
at N.E. corner of Halycross to 15 1/2' W.

Bearing of line S. 5° W.
→ at R.S. stone of Champaign Co
Line.

$$\frac{15}{80} \times 5\frac{1}{2} + 10' = \underline{11.03'}$$

Measure E 11' on line between
Halycross and Rausenberger and
get S.W. corner Harner (Set stake)

This point falls west of present
fence