

Section Corner at Nellie Bigley Spark's
Drive




Stamped Nov. 19 1942 RMR

Gilmkeop
F. Hurst
R. McGarvey
9-15-42

8

Rd 43 - Cor 12, 7, 8 T3 R14
Found large boulder with white
stakes beside
Set concrete 11071 4" below surface

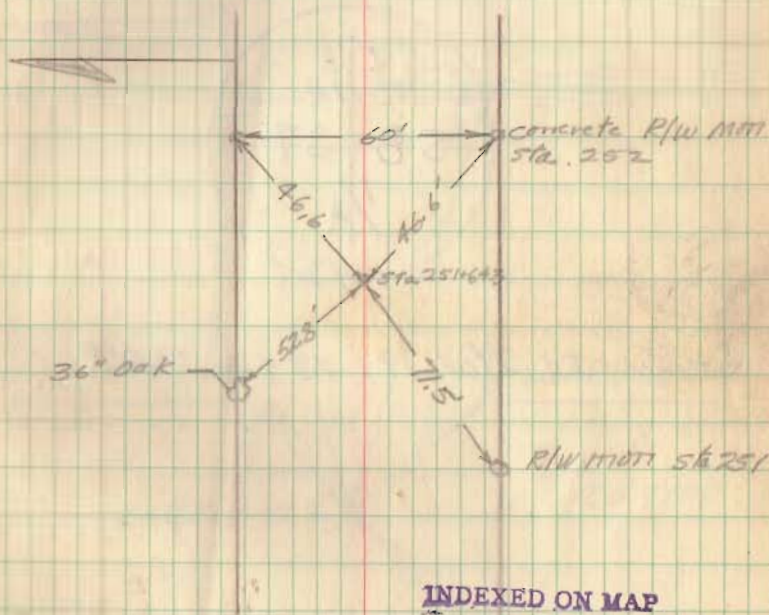

Elevation: 1134.60

INDEXED ON MAP

2624 Union Trip.

INDEXED ON MAP