

Intersection of Road 43 - Road 31




Stamped Nov 18 1942 RHR

G. W. Skeep  
F. Hurst  
R. McGurvy  
9-18-47

14

Rd 43 - Cor 19, 20, 25, 26 T3 R14  
Found wooden hub on top of  
large stone - broken brick  
Set concrete man 4" below surface

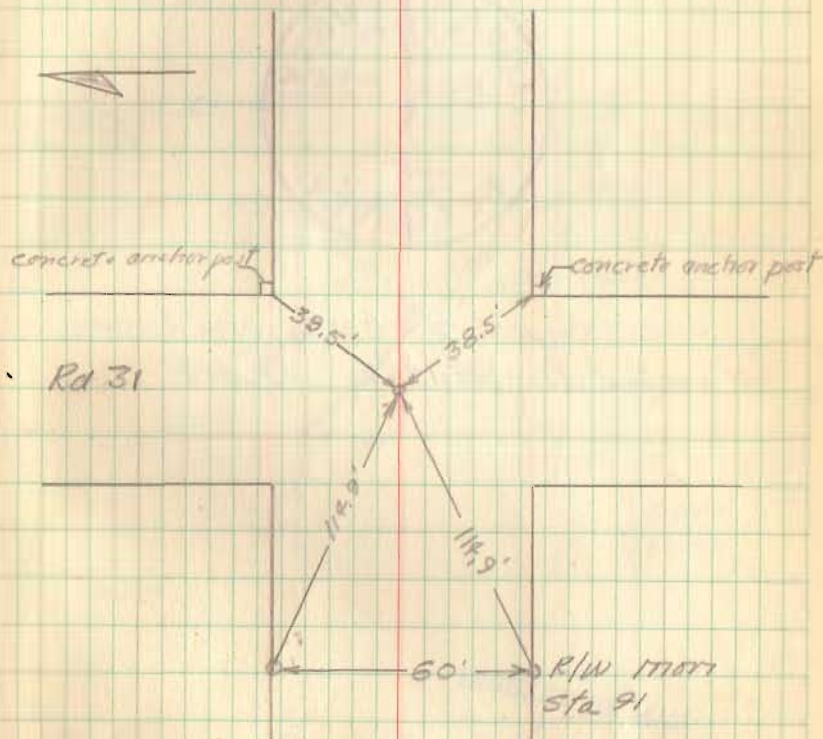

Elevation: 1076.12

INDEXED ON MAP

2630

Union  
Twp.

INDEXED ON MAP